IREDELL COUNTY HEALTH DEPARTMENT

Statesville Phone TR 3-7271 Mooresville Phone No. 664-5281

PERMIT TO INSTALL SEPTIC TANK

Permit No. 33 Permit Date 3-13-1973

Owner Carl Fulford Address Wilmington

Installed By Orbison Address Mooresville


Location of Property Perth Rd north from 150 Thon 1428 approx 2mi on right

Tank		Capacity		Length of Lines		Fixtures	
Block	( )	1000	(✓)	225'	(✓)	No. of Baths	(2)
Precast	(✓)	1250	( )	250'	( )	Dishwasher	(no)
		1500	( )	Other		Garbage Grdr.	(no)
		Other				Other Washing Machine	

NOTIFY HEALTH DEPARTMENT AT LEAST EIGHT HOURS BEFORE TANK IS TO BE INSPECTED.

Final Inspection 3-13-1973 Approved (✓) Disapproved ( )

Remarks

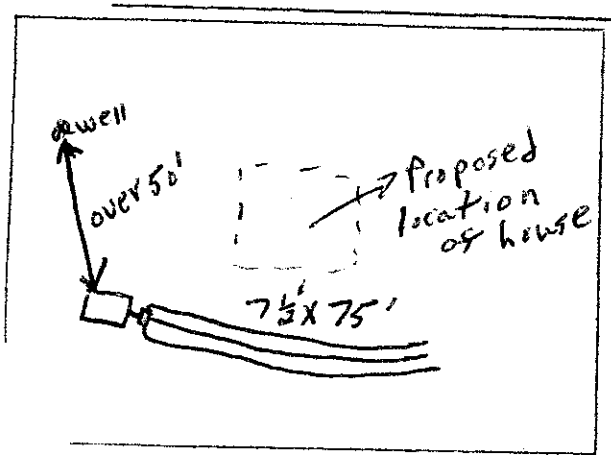

Sketch of Installation

J. C. Moore
Sanitarian