IREDELL COUNTY HEALTH DEPARTMENT

STATESVILLE 704-878-5305 MOORESVILLE 704-664-5281

IMPROVEMENT PERMIT / AUTHORIZATION TO CONSTRUCT / OPERATION PERMIT / EXISTING SYSTEM INSPECTION

375.00 Paid 3:00

PERMIT# 108868 PIN# 4638-44-3393 DATE 12/11/02

OWNER OR CONTRACTOR ~~Keith Hedges~~ John Dennis PHONE: Business _____ Home 910-395-4527

ADDRESS 3305 Tudor Ct. Wilmington NC 28409

LOCATION Perth TL Normandy, on Lt

SUBDIVISION LNAP BLOCK / SECTION _____ LOT 25 LOT AREA 1.32 Ac. SITE CLASS. PS DESIGN FLOW 360 L.T.A.R. 0.3 Initial / 0.2 Rep.

Septic Tank: 1000 Gallons; STB 312 Date 11-17-04
Pump Tank: 1000 Gallons; PT 283 Date 10-29-04
Pump Make: Goulds Model WE0312M Serial No. _____
Nitrification Field: No Fields 1 Square Feet 600 Linear Feet 200
No Lines 5 Trench Width 24" Max Trench Bottom Depth 36" Gravel Depth —

☒ New System ☐ Repair System Type: I, II, III, IV, V, VI
System Description: LP Panel Block
Repair System Description: Same
Maintenance Agreement Required: ☒ Yes ☐ No


☒ House/Mod. Home No. Bedrooms 3
☐ Mobile Home No. Bathrooms 2½
☐ Business No. Employees _____
☐ Other _____
☐ Slab ☐ Crawl Space ☐ Basement w/plumbing ☒ Basement wo/plumbing

Water Supply: ☒ Individual ☐ Public ☐ Community

The proposed / existing Airplane Hangar addition does not appear to impact the existing septic system.
**NOTE: ~~Do Not~~ Route Taxi-Way across Neighbor's Repair Area
Maine Dotson R.S.
Date: 8/13/12
Until new Rep. ICHD-Environmental Health Division

Comments/Conditions: Checked tanks & lines 11/11/05 mp
Checked pressure, elect & alarm 3/15/05

AS BUILT SKETCH

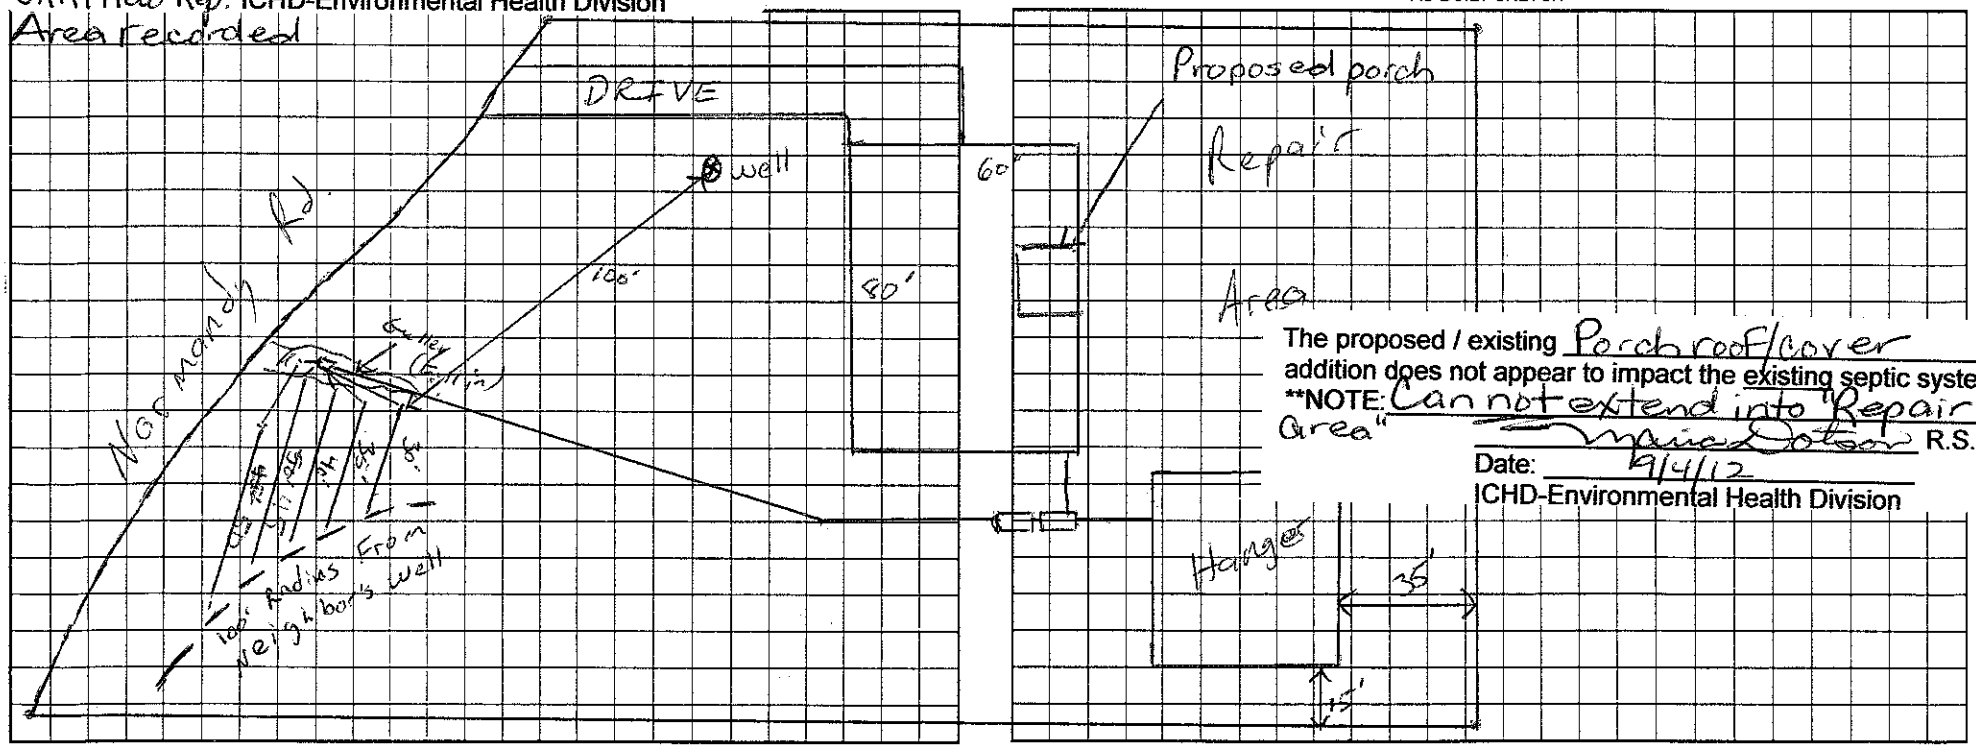

The proposed / existing Porch roof/cover addition does not appear to impact the existing septic system.
**NOTE: Can not extend into "Repair Area"
Maine Dotson R.S.
Date: 9/4/12
ICHD-Environmental Health Division

Permit can be suspended or revoked if any false information is supplied toward securing the permit/any unauthorized changes are made to the site/any unauthorized changes are made in the installation of the system. Improvement Permit with plat valid without expiration. Improvement Permit with site plan valid for sixty months. Authorization to Construct is valid for a period equal to that of Improvement Permit – not to exceed sixty months.

Signed: _____ date 12/13/02 Installed by: R.E. Dotson R.S.

Improvement Permit by: _____ RS date 12/11/02 Operation Permit by: Maine Dotson date 3/15/05

Authorization to Construct by: _____ RS date 12/11/02 Existing System Inspection by: _____ date _____

HEALTH DEPT. COPY: WHITE OWNER COPY (FINAL): YELLOW OWNER COPY (INITIAL): PINK