IREDELL COUNTY HEALTH DEPARTMENT

STATESVILLE 704-878-5305 MOORESVILLE 704-664-5281

IMPROVEMENT PERMIT / AUTHORIZATION TO CONSTRUCT / OPERATION PERMIT / EXISTING SYSTEM INSPECTION

PERMIT # NA PIN # 4638 44 4024 DATE 7/28/09

OWNER or APPLICANT MICHAEL GALE NICHOLS PHONE: Business Home: 704-664-7444

OWNER or APPLICANT ADDRESS 419 NORMANDY RD. MOORESVILLE, NC. 28117

LOCATION / DIRECTIONS Perth N to L Normandy Rd., on (L) # 419

SUBDIVISION LK NORMAN AIRPARK BLOCK / SECTION LOT # 27 LOT AREA ~1 AC DESIGN FLOW 360 L.T.A.R. .3

Septic Tank 1000 Gallons: STB 794 Date 11/22/06 ☐ New System ☒ Repair ☒ Expansion System Type I II (III) IV V VI

Pump Tank Gallons: P T Date System Description:

Pump Make Model Serial # Repair System Description: 1000 TANK + REROUTE LINE

Nitrification Field No Fields Trench Width 2' No Lines 4 Linear Feet 280 Max. Trench Bottom Depth 3' Gravel Depth No Maintenance Agreement Required ☒ YES ☐ NO ☐ GRAVITY ☒ PRESSURE


☒ Residence No. Bedrooms 3 ☐ Business No. Persons ☐ Other No. Employees ☐ Slab ☐ Crawl Space ☒ Basement w/plumbing ☐ Basement w/o plumbing

Water Supply: ☒ Private ☐ Public ☐ Community

Comments / Conditions

Comments / Conditions

INITIAL SITE SKETCH

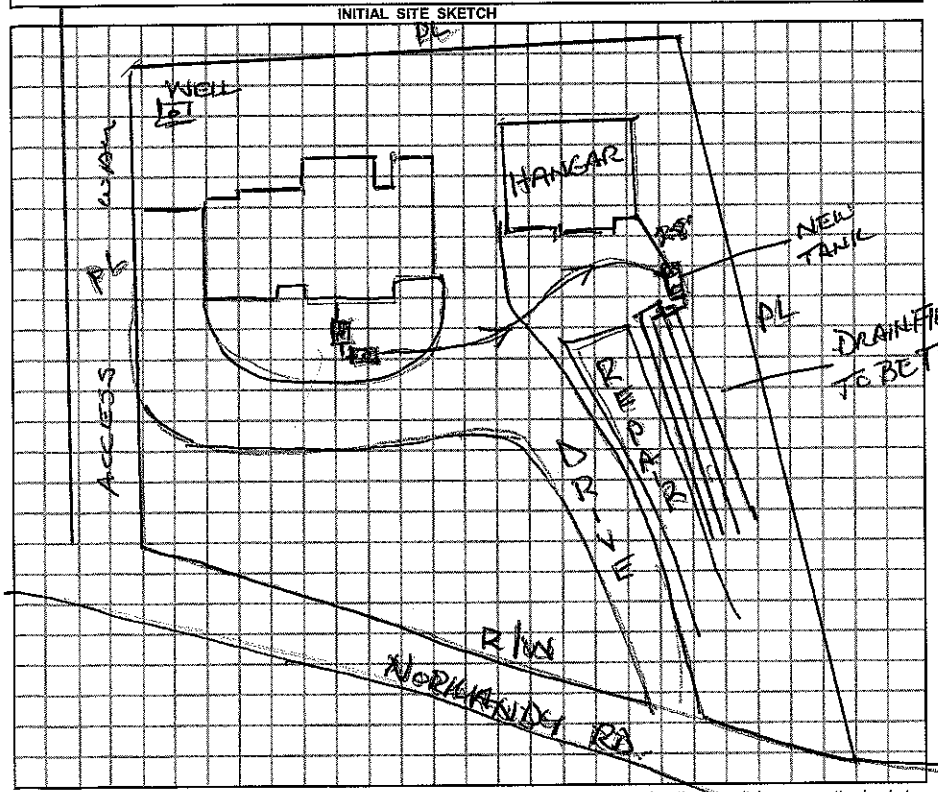

AS BUILT SKETCH

Permit can be suspended or revoked if any false information is supplied toward securing the permit / any unauthorized changes are made to the site / any unauthorized changes are made in the installation of the system.

☐ *IMPROVEMENT PERMIT w / plat valid without expiration.* ☐ *IMPROVEMENT PERMIT w / site plan valid for 60 mos.* ☐ *AUTHORIZATION TO CONSTRUCT valid for period equal to IMPROVEMENT PERMIT-not to exceed 60 mo.*

Owner / Applicant Signature: Date

Improvement Permit by: Date

Authorzation to Construct by: Date

YOU SHOULD CONTACT A LOCATOR SERVICE PRIOR TO ANY EXCAVATION.

Installed by: Richard Abernathy

Operation Permit by: Wesley Sparks R.S. Date: 7/28/09

Existing System Inspected by: Date:

WHITE COPY Environmental Health YELLOW COPY (Final) Owner / Applicant PINK COPY (Initial) Owner / Applicant