# IREDELL COUNTY HEALTH DEPARTMENT / A Abrogation to Construct

STATESVILLE 704-878-5305 MOORESVILLE 704-664-5281

## IMPROVEMENT PERMIT / ~~CERTIFICATE OF COMPLETION~~ / OPERATION PERMIT / EXISTING SYSTEM INSPECTION

PROPERTY DESCRIPTION NO. 22477 DATE 12/22/95 TAX MAP NO. LP 4 - A - 184 4638 44 7032 Watershed: [X] Yes [ ] No

OWNER OR CONTRACTOR Anthony Mariano PHONE: Business _____ Home 209-835-8089

ADDRESS 217 Benedict Tracy, Calif. 95376

LOCATION Hammerly Rd. TL on Amelia Ave, to cul de sac, property on (L) of cul de sac

SUBDIVISION LN Airpark BLOCK / SECTION _____ LOT 29 LOT AREA 1.01 Ac SITE CLASS PS DESIGN FLOW 480 L.T.A.R. .3

Septic Tank: 1000 Gallons; STB 1012 Date 11/5/98

Pump Tank: 1000 Gallons; PT 17 Date 3/11/98

Pump Make: _____ Model _____ Serial No. _____

Nitrification Field: No Fields 1 Square Feet 1600 Linear Feet 400 *

No Lines 4 Trench Width 36" Max Trench Bottom Depth 36" Gravel Depth 6" SAND

[X] New System [ ] Repair System Type: I. II (III) IV. V. VI

System Description: Press to GRAV INFILTRATOR

Repair System Description: Pres. INFILTRATOR

Maintenance Agreement Required: [ ] Yes [X] No

[X] House/Mod. Home No. Bedrooms 4

[ ] Mobile Home No. Bathrooms 5.5

[ ] Business No. Employees _____

[ ] Other _____


[ ] Slab [X] Crawl Space [ ] Basement w/plumbing [ ] Basement wo/plumbing

Water Supply: [X] Individual [ ] Community [ ] Public


Comments: Sand required to backfill to top of louvers.

Comments: 140' 1M - FH

### INITIAL SITE SKETCH

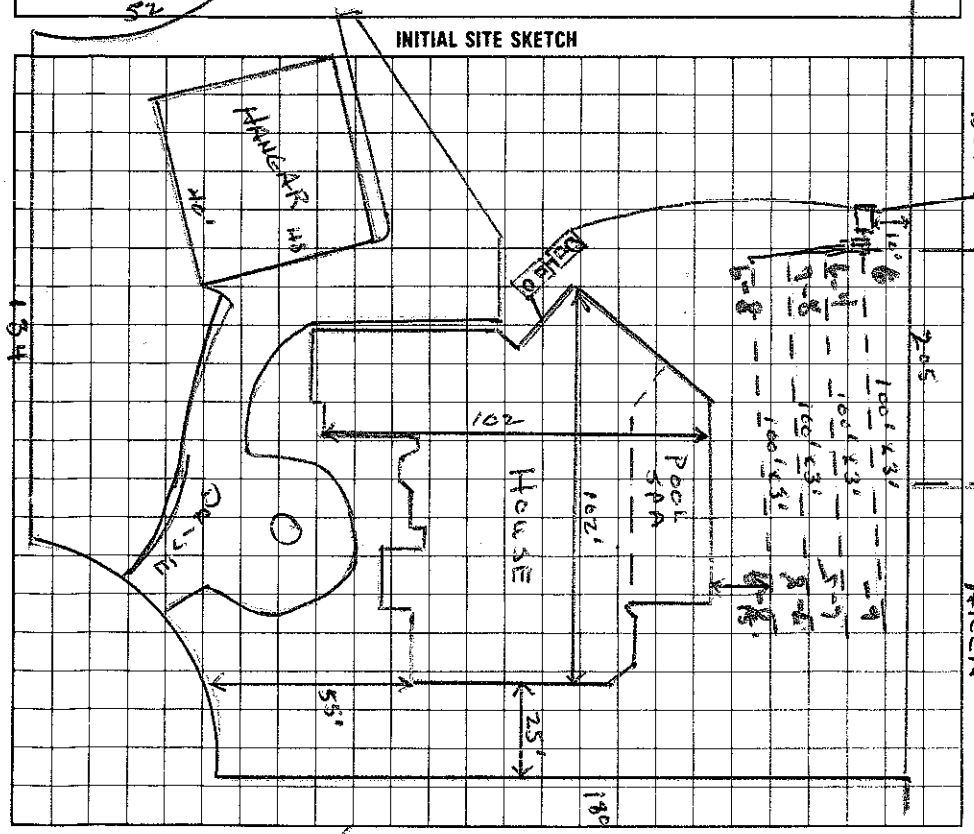


### AS BUILT SKETCH

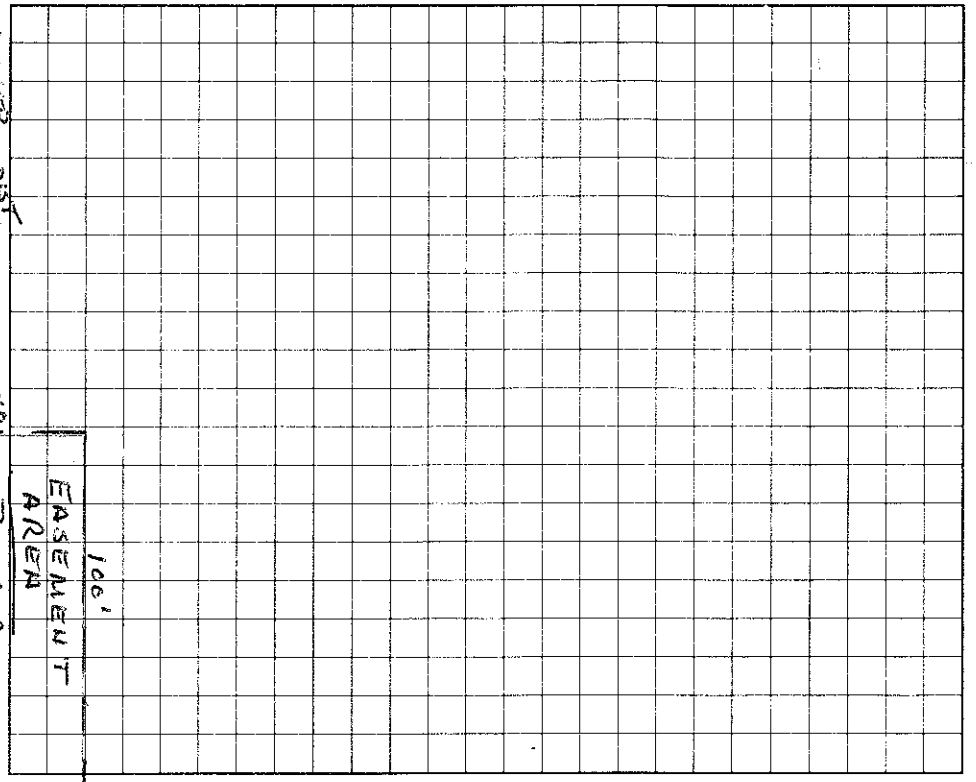


I understand that this permit can be suspended or revoked if any false information is supplied toward securing the permit/any unauthorized changes are made to the site/any unauthorized changes are made in the installation of the system.

Signed: Anthony J Mariano

Improvement Permit by: Wesley Sparks RS. date 1/19/96

~~Certificate of Completion by:~~ Wesley Sparks RS. date 1/19/96

Existing System Inspection by: Wesley Sparks RS. date 1/19/96

Installed by: Forrest Shuford

Certificate of Completion by: Wesley Sparks R.S. date 7/31/98

Operation Permit by: Wesley Sparks R.S. date 7/31/98

HEALTH DEPT. COPY: WHITE INSPECTION COPY (FINAL): GREEN OWNER COPY (FINAL): YELLOW INSPECTION COPY (INITIAL): PINK OWNER COPY (INITIAL): GOLD