2.30

IREDELL COUNTY HEALTH DEPARTMENT

STATESVILLE 704-878-5305 MOORESVILLE 704-664-5281

IMPROVEMENT PERMIT / AUTHORIZATION TO CONSTRUCT / OPERATION PERMIT / EXISTING SYSTEM INSPECTION

PERMIT# 079655 PIN# 4638453630 DATE 5/28/99

OWNER OR CONTRACTOR Donald Sink PHONE: Business _____ Home 704-663-5834

ADDRESS 117 Eagle Ct Mooresville NC 28117

LOCATION 150W, TR Portla, TL Normandy, 3/4 Mile on Left

SUBDIVISION Lake Norman Airpk BLOCK / SECTION _____ LOT 22 LOT AREA 1.46 SITE CLASS. PS DESIGN FLOW 360 L.T.A.R. .3

Septic Tank: 1000 Gallons; STB 97 Date 3/7/00
Pump Tank: _____ Gallons; PT _____ Date _____
Pump Make: _____ Model _____ Serial No. _____
Nitrification Field: No Fields 1 Square Feet 1200 Linear Feet 400
No Lines 5@80 Trench Width 36" Max Trench Bottom Depth 26" Gravel Depth 12"

☒ New System ☐ Repair System Type: I (II) III, IV, V, VI
System Description: Grav./Conv.
Repair System Description: Chamber/Panel
Maintenance Agreement Required: ☐ Yes ☐ No


☒ House/Mod. Home No. Bedrooms 3
☐ Mobile Home No. Bathrooms 2
☐ Business No. Employees ____
☐ Other _____
☐ Slab ☒ Crawl Space ☐ Basement w/plumbing ☐ Basement wo/plumbing

Water Supply: ☒ Individual ☐ Public ☐ Community

Comments:/Conditions:

Comments:/Conditions:

INITIAL SITE SKETCH

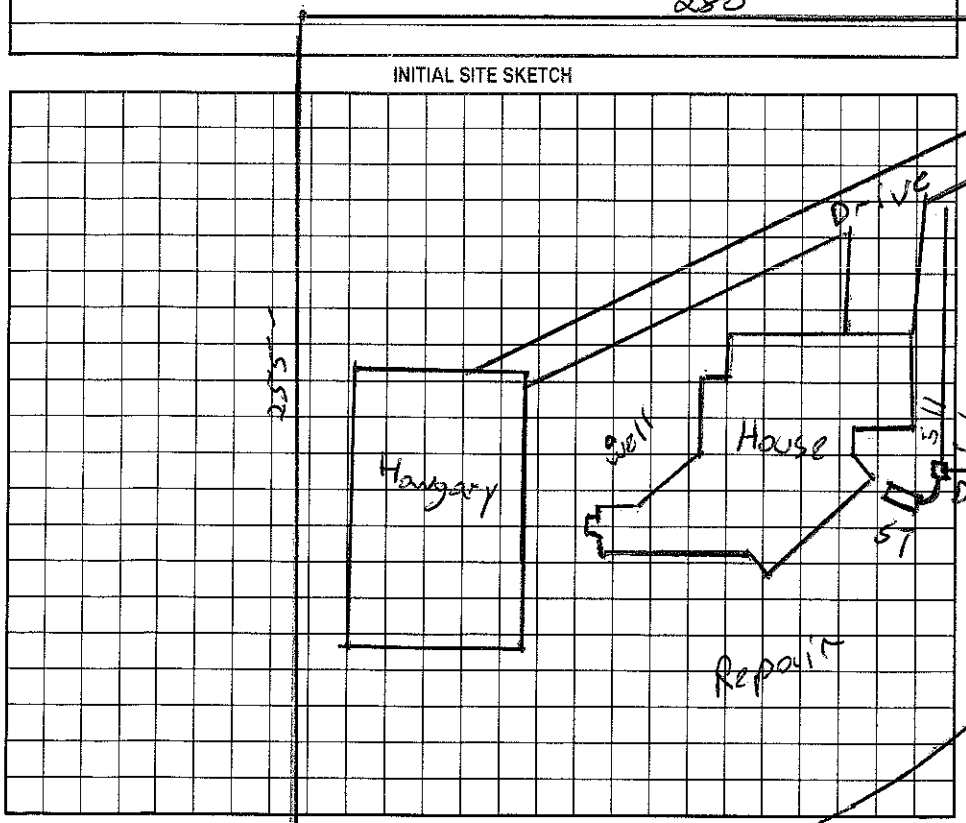

AS BUILT SKETCH

Permit can be suspended or revoked if any false information is supplied toward securing the permit/any unauthorized changes are made to the site/any unauthorized changes are made in the installation of the system. Improvement Permit with plat valid without expiration. ~~Improvement Permit with site plan valid~~ for sixty months. Authorization to Construct is valid for a period equal to that of Improvement Permit – not to exceed sixty months.

Signed: Donald W. Sink date 6/1/99

Improvement Permit by: Jeff Mason date 5/28/99

Authorization to Construct by: Jeff Mason date 5/28/99

Installed by: WT Worwood

Operation Permit by: [signature] date 6/1/00

Existing System Inspection by: _____ date _____

HEALTH DEPT. COPY: WHITE OWNER COPY (FINAL): YELLOW OWNER COPY (INITIAL): PINK