IREDELL COUNTY HEALTH DEPARTMENT

STATESVILLE 704-878-5305 MOORESVILLE 704-664-5281

IMPROVEMENT PERMIT / CERTIFICATE OF COMPLETION / OPERATION PERMIT / EXISTING SYSTEM INSPECTION

PROPERTY DESCRIPTION NO. 19657 DATE 10/28/94 TAX MAP NO. 2P-4-A-175 Watershed: ☐ Yes ☑ No

OWNER OR CONTRACTOR Howard A Cochran Jr PHONE: Business 896-5507 Home

ADDRESS 20000 E ONE Norman Circle Davidson, NC. 28036 463-45-4474

LOCATION Normandy Rd. - on L just past Lindbergh Ln.

SUBDIVISION LN Airfield BLOCK / SECTION I LOT 21 LOT AREA ~1.26 SITE CLASS. P DESIGN FLOW 360 L.T.A.R. .35

Septic Tank: 1000 Gallons; STB 897 Date 2/6/95

Pump Tank: Gallons; PT Date

Pump Make: Model Serial No.

Nitrification Field: No Fields 1 Square Feet 1028 Linear Feet 342-440

No Lines 4-5 Trench Width 36" Max Trench Bottom Depth 36" Gravel Depth 12"

☑ New System ☐ Repair System Type: I (II) III, IV, V, VI

System Description: Conv - Drop Box

Repair System Description:

Maintenance Agreement Required: ☐ Yes ☑ No

☑ House/Mod. Home ☐ Mobile Home ☐ Business ☐ Other

No. Bedrooms 3 No. Bathrooms 2 No. Employees

☑ Slab ☑ Crawl Space ☐ Basement w/plumbing ☐ Basement wo/plumbing


Water Supply: ☑ Individual ☐ Community ☐ Public

Comments:

House System -

Comments:

INITIAL SITE SKETCH

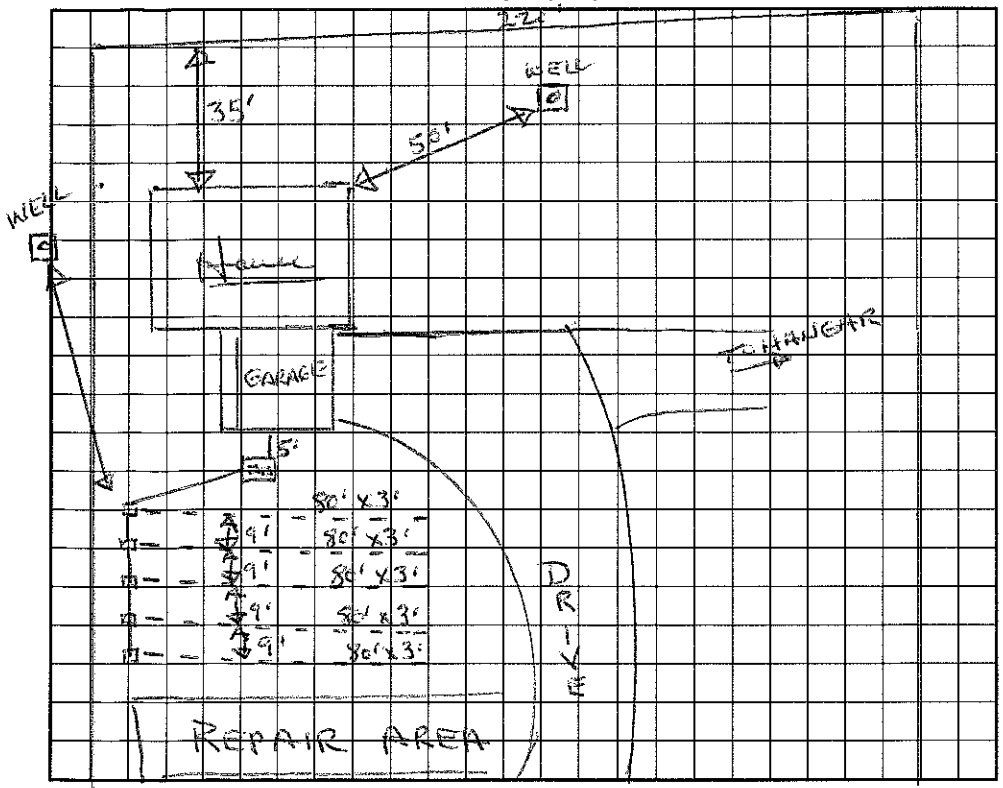

AS BUILT SKETCH

I understand that this permit can be suspended or revoked if any false information is supplied toward securing the permit/any unauthorized changes are made to the site/any unauthorized changes are made in the installation of the system. Improvement Permit is valid for 60 months from date of issuance.

Signed: Howard A. Cochran Jr. 10/28/94

Improvement Permit by: Wesley Sparks RS date 10/28/94

Existing System Inspection by: date

Installed by: WT Norwood

Certificate of Completion by: Wesley Sparks RS date 5/1/95

Operation Permit by: date

HEALTH DEPT. COPY: WHITE INSPECTION COPY (FINAL): GREEN OWNER COPY (FINAL): YELLOW INSPECTION COPY (INITIAL): PINK OWNER COPY (INITIAL): GOLD

IREDELL COUNTY HEALTH DEPARTMENT

STATESVILLE 704-878-5305 MOORESVILLE 704-664-5281

IMPROVEMENT PERMIT / CERTIFICATE OF COMPLETION / OPERATION PERMIT / EXISTING SYSTEM INSPECTION

PROPERTY DESCRIPTION NO. 19657 DATE 10/28/94 TAX MAP NO. 2P 4A 175 Watershed: ☐ Yes ☒ No

OWNER OR CONTRACTOR Howard Cochran PHONE: Business 896-5507 Home

ADDRESS

LOCATION Normandy Rd.

SUBDIVISION LN Air Park I BLOCK / SECTION LOT 21 LOT AREA 2.28 SITE CLASS. P DESIGN FLOW 240 L.T.A.R.

Septic Tank: 900 Gallons; STB 897 Date 2/22/95

Pump Tank: Gallons; PT Date

Pump Make: Model Serial No.

Nitrification Field: No Fields 1 Square Feet 420 Linear Feet 140

No Lines 2 Trench Width 36" Max Trench Bottom Depth 12" Gravel Depth 12"

☒ New System ☐ Repair System Type: I, ☒ II, III, IV, V, VI

System Description: Conv.

Repair System Description:

Maintenance Agreement Required: ☐ Yes ☒ No

☐ House/Mod. Home No. Bedrooms

☐ Mobile Home No. Bathrooms

☐ Business No. Employees

☒ Other 1 Bathroom

☐ Slab ☐ Crawl Space ☐ Basement w/plumbing ☐ Basement wo/plumbing


Water Supply: ☒ Individual ☐ Community ☐ Public

Comments:

Hanger System.

Comments:

INITIAL SITE SKETCH

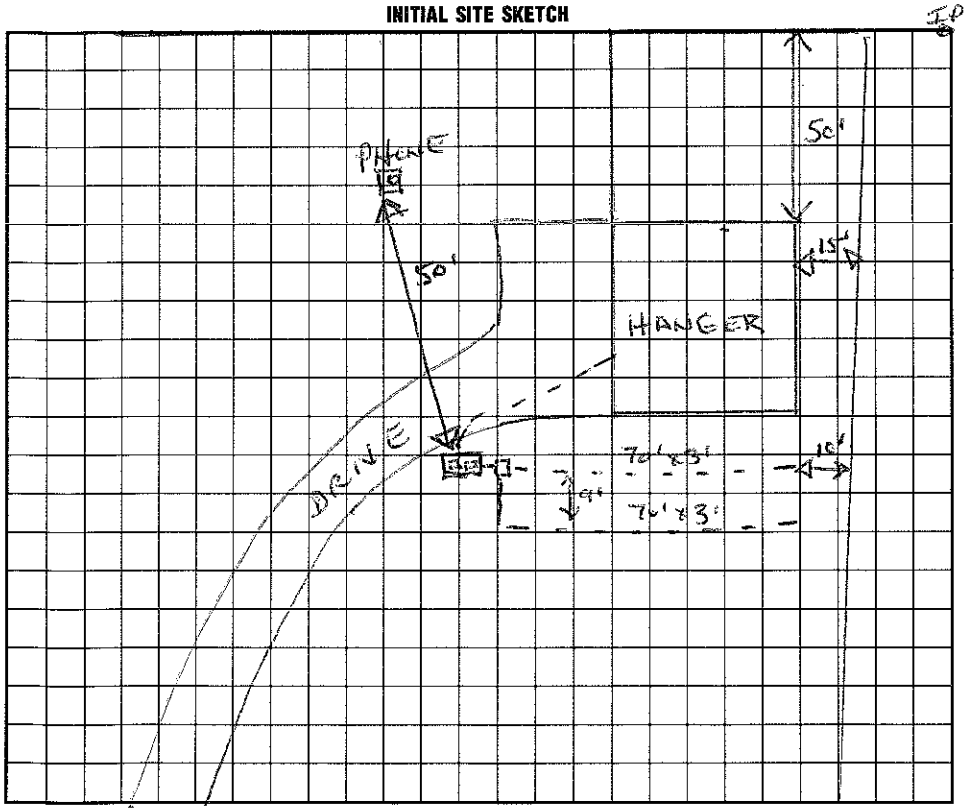

AS BUILT SKETCH

I understand that this permit can be suspended or revoked if any false information is supplied toward securing the permit/any unauthorized changes are made to the site/any unauthorized changes are made in the installation of the system. Improvement Permit is valid for 60 months from date of issuance.

Signed: Howard A. Cochran Jr. 10/28/94

Improvement Permit by: Wesley Sparks RS. date 10/28/94

Existing System Inspection by: date

Installed by: WT Norwood

Certificate of Completion by: Wesley Sparks RS. date 5/1/95

Operation Permit by: date

HEALTH DEPT. COPY: WHITE INSPECTION COPY (FINAL): GREEN OWNER COPY (FINAL): YELLOW INSPECTION COPY (INITIAL): PINK OWNER COPY (INITIAL): GOLD