IREDELL COUNTY HEALTH DEPARTMENT

STATESVILLE 704-878-5305 MOORESVILLE 704-664-5281

IMPROVEMENT PERMIT / CERTIFICATE OF COMPLETION / OPERATION PERMIT / EXISTING SYSTEM INSPECTION

PROPERTY DESCRIPTION NO. 15615 DATE 10/18/94 TAX MAP NO. 2PA 17A Watershed: ☐ Yes ☐ No

OWNER OR CONTRACTOR Warren Hulbert ~~PHONE: Business~~ 4638-45-6351 Home 892-3010

ADDRESS Normandy Rd. ~ .7 mile on (L)

LOCATION

SUBDIVISION LN Air Park BLOCK / SECTION LOT 20 LOT AREA ~1Ac SITE CLASS. P DESIGN FLOW 360 L.T.A.R. < 3

Septic Tank: 1000 Gallons; STB 1012 Date 8-8-94
Pump Tank: Gallons; PT Date
Pump Make: Model Serial No.
Nitrification Field: No Fields 1 Square Feet 1200 Linear Feet 400
No Lines 4 Trench Width 36" Max Trench Bottom Depth 36" Gravel Depth 12"

☑ New System ☐ Repair System Type: I, II, III, IV, V, VI
System Description: DROP BOX CONV
Repair System Description: SAME
Maintenance Agreement Required: ☐ Yes ☐ No

☑ House/Mod. Home No. Bedrooms 3
☐ Mobile Home No. Bathrooms 2
☐ Business No. Employees
☐ Other
☐ Slab ☑ Crawl Space ☐ Basement w/plumbing ☐ Basement wo/plumbing


Water Supply:
☑ Individual
☐ Community
☐ Public

Comments:

INITIAL SITE SKETCH

Comments:

AS BUILT SKETCH

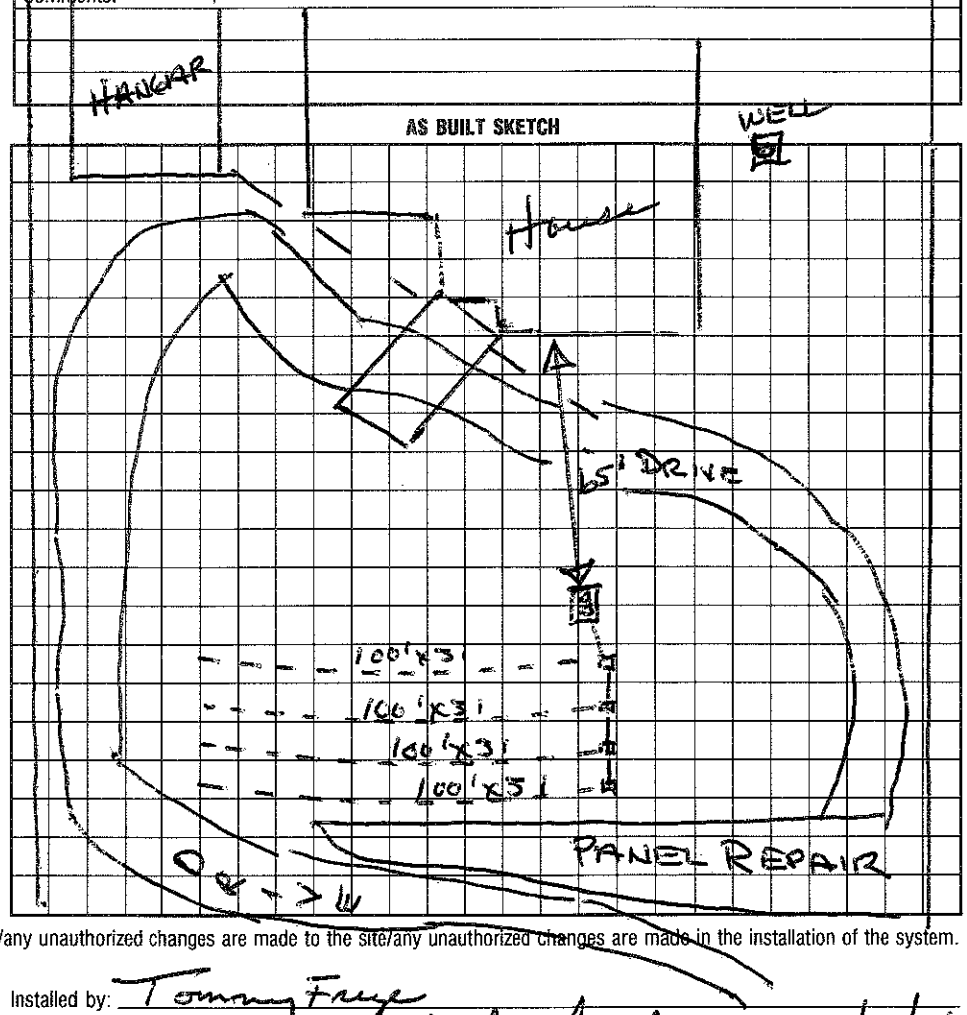

I understand that this permit can be suspended or revoked if any false information is supplied toward securing the permit/any unauthorized changes are made to the site/any unauthorized changes are made in the installation of the system. Improvement Permit is valid for 60 months from date of issuance.

Signed:

Improvement Permit by: date

Existing System Inspection by: date

Installed by: Tommy Frye

Certificate of Completion by: Wesley Sparkes date 10/18/94

Operation Permit by: date

HEALTH DEPT. COPY: WHITE INSPECTION COPY (FINAL): GREEN OWNER COPY (FINAL): YELLOW INSPECTION COPY (INITIAL): PINK OWNER COPY (INITIAL): GOLD