4038456695

IREDELL COUNTY HEALTH DEPARTMENT

STATESVILLE 704-878-5305 MOORESVILLE 704-664-5281

IMPROVEMENT PERMIT / CERTIFICATE OF COMPLETION / OPERATION PERMIT / EXISTING SYSTEM INSPECTION

PROPERTY DESCRIPTION NO. 19139 DATE 6/29/94 TAX MAP NO. 2P 4A 86 Watershed: ☐ Yes ☒ No

OWNER OR CONTRACTOR Anthony Fragoine PHONE: Business _____ Home 399-3700

ADDRESS 304 Normandy Rd. Mooresville NC. 28115

LOCATION Normandy Rd; Perth N TL on Normandy Rd. ~.4 mile on (R)

SUBDIVISION CL+T BLOCK (SECTION) 11 LOT 86 LOT AREA ~.97 SITE CLASS. P DESIGN FLOW 480 L.T.A.R. .25-.3

Septic Tank: 1000 Gallons; STB _____ Date _____

Pump Tank: _____ Gallons; PT _____ Date _____

Pump Make: _____ Model _____ Serial No. _____

Nitrification Field: No Fields 1 Square Feet 540 Linear Feet 150

No Lines 3 Trench Width 3' Max Trench Bottom Depth 36 Gravel Depth _____

☒ New System ☐ Repair System Type: I (II) III IV, V, VI

System Description: ADDITION

Repair System Description: _____

Maintenance Agreement Required: ☐ Yes ☒ No

☒ House/Mod. Home No. Bedrooms 4

☐ Mobile Home No. Bathrooms 3

☐ Business No. Employees _____

☐ Other _____


☐ Slab ☒ Crawl Space ☐ Basement w/plumbing ☐ Basement wo/plumbing

Water Supply: ☒ Individual ☐ Community ☐ Public

Comments:

50' 760 CONTOUR

INITIAL SITE SKETCH

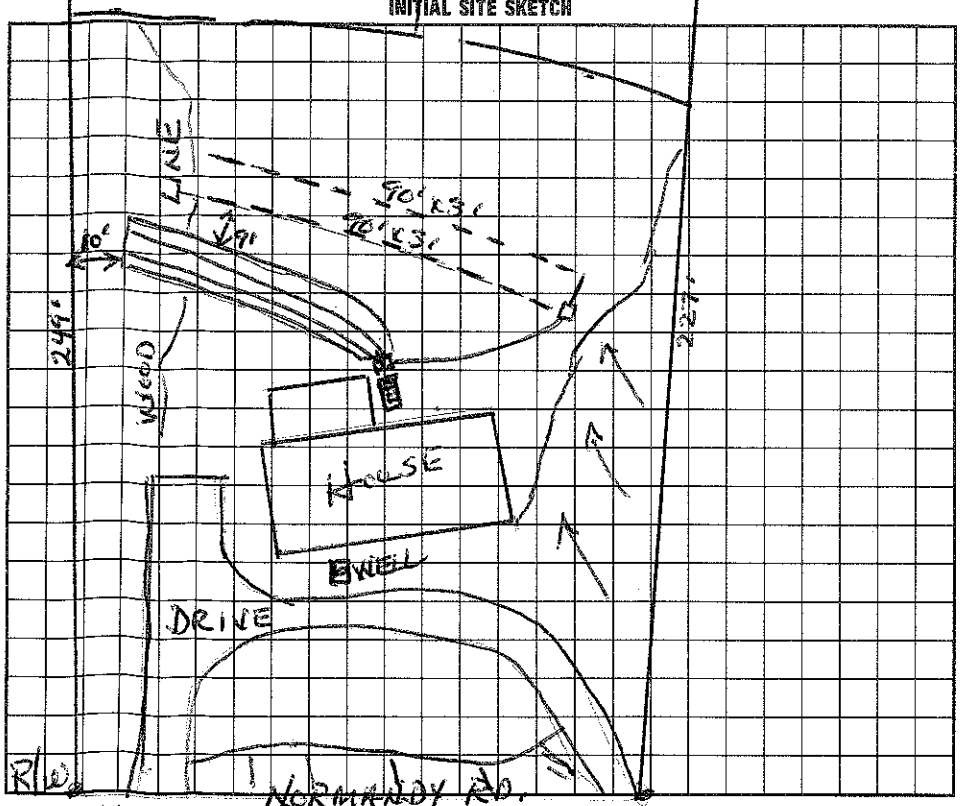


Comments:

3 at 50' x 3' of PLASTIC

760 CONTOUR

AS BUILT SKETCH

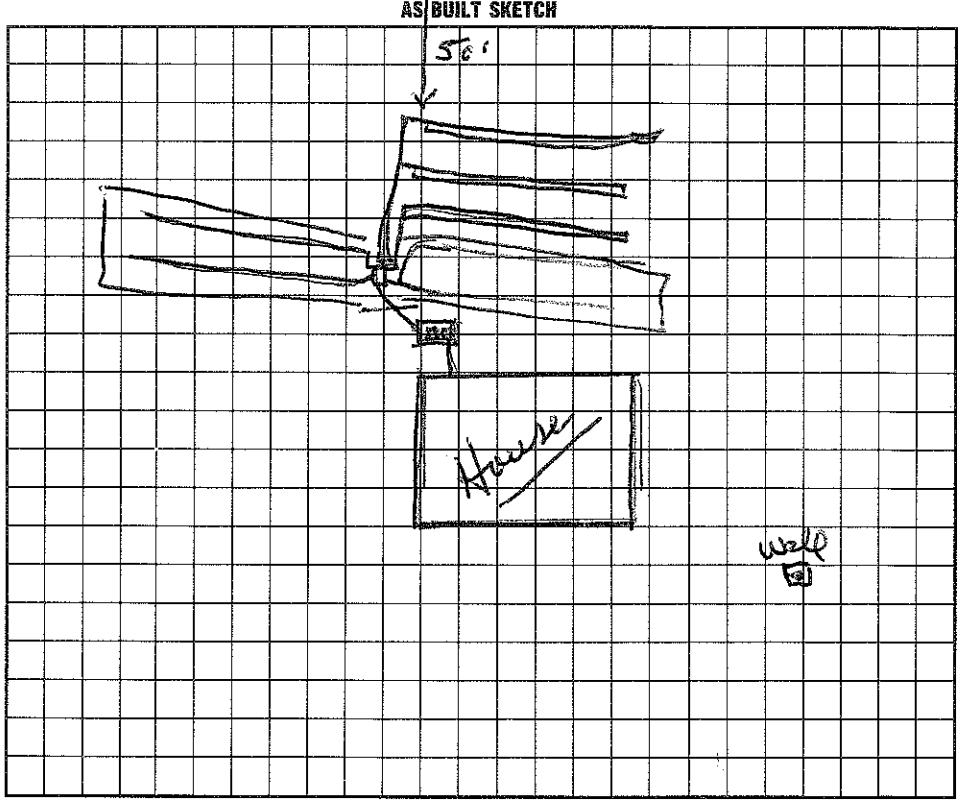

I understand that this permit can be suspended or revoked if any false information is supplied toward securing the permit/any unauthorized changes are made to the site/any unauthorized changes are made in the installation of the system. Improvement Permit is valid for 60 months from date of issuance.

Signed: _____ AGENT

Improvement Permit by: Wesley Sparks RS. date 6/29/94

Existing System Inspection by: _____ date _____

Installed by: Julian Bowles

Certificate of Completion by: _____ date _____

Operation Permit by: Wesley Sparks RS date 9/23/96

HEALTH DEPT. COPY: WHITE INSPECTION COPY (FINAL): GREEN OWNER COPY (FINAL): YELLOW INSPECTION COPY (INITIAL): PINK OWNER COPY (INITIAL): GOLD