IREDELL COUNTY HEALTH DEPARTMENT

STATESVILLE 704-878-5305 MOORESVILLE 704-664-5281

IMPROVEMENT PERMIT / AUTHORIZATION TO CONSTRUCT / OPERATION PERMIT / EXISTING SYSTEM INSPECTION

PERMIT# D89433 PIN# 4638459632 DATE 5-8-2000

OWNER OR CONTRACTOR David Fowler PHONE: Business 609-2802 Home 663-0731

ADDRESS 118 Dunsmere Ln Mooresville NC 28117

LOCATION Hwy 150 W TR Perth Rd LT Normandy TR - Dunsmere on left

SUBDIVISION CEDAR BLOCK / SECTION 11 LOT 84 LOT AREA .92 Acre SITE CLASS. PS DESIGN FLOW 360 gpd L.T.A.R.

Septic Tank: Existing Gallons; STB Date

Pump Tank: Gallons; PT Date

Pump Make: Model Serial No.

Nitrification Field: No Fields 1 Square Feet 625 Linear Feet 250'

No Lines Bed 7.5'x84' Trench Width Max Trench Bottom Depth Gravel Depth

☐ New System ☐ Repair System Type: I, II, III, IV, V, VI

System Description: Existing Grav. - Conventional

Repair System Description:

Maintenance Agreement Required: ☐ Yes ☐ No

☒ House/Mod. Home No. Bedrooms 3

☐ Mobile Home No. Bathrooms 2.5

☐ Business No. Employees

☐ Other


☐ Slab ☐ Crawl Space ☐ Basement w/plumbing ☒ Basement wo/plumbing

Water Supply:
☒ Individual
☐ Public
☐ Community


Comments:/Conditions: Existing Septic System appears to be functioning at time of inspection, No problems Noticed. Sized for 3 Bedroom, approved for 3 Bedroom

Comments:/Conditions: System originally installed in 1978, reinspected 1983

INITIAL SITE SKETCH Not to Scale

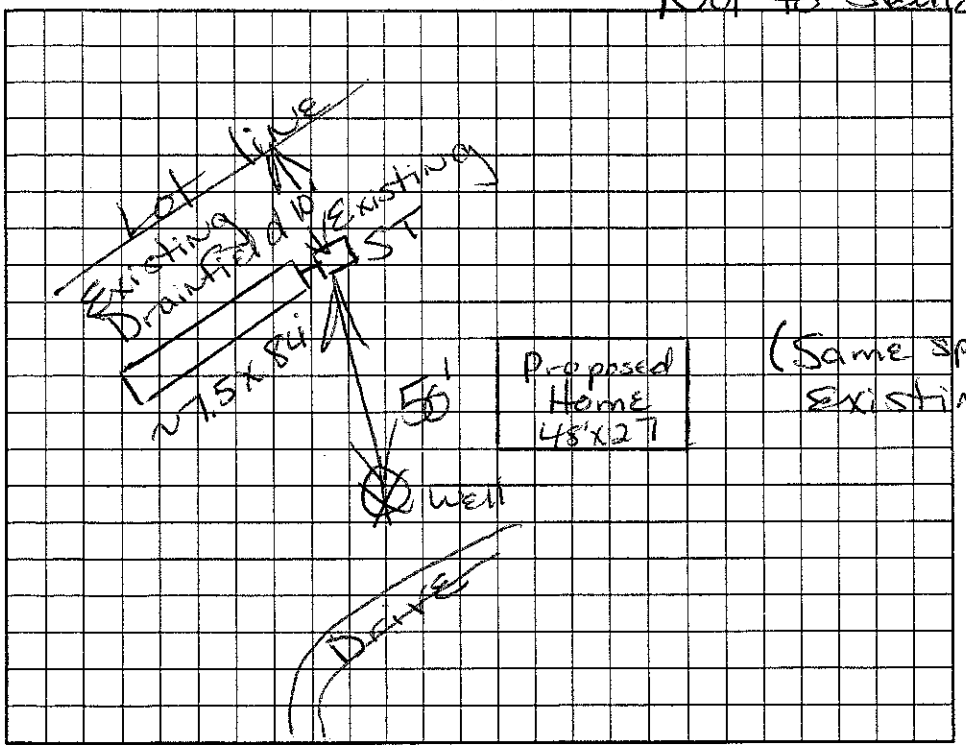

AS BUILT SKETCH

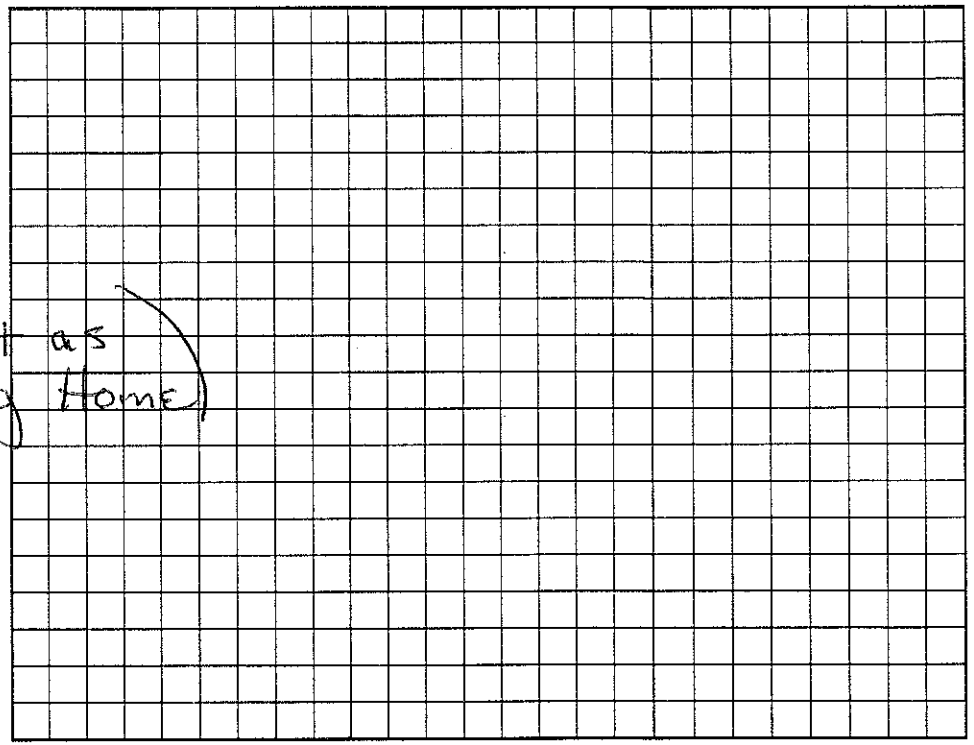

Permit can be suspended or revoked if any false information is supplied toward securing the permit/any unauthorized changes are made to the site/any unauthorized changes are made in the installation of the system. Improvement Permit with plat valid without expiration/ Improvement Permit with site plan valid for sixty months. Authorization to Construct is valid for a period equal to that of Improvement Permit – not to exceed sixty months.

Signed: David Fowler date Installed by:

Improvement Permit by: Maria H. Dotson RS date 5/8/2000 Operation Permit by: date

Authorization to Construct by: date Existing System Inspection by: Maria H. Dotson RS date 5/8/2000

HEALTH DEPT. COPY: WHITE OWNER COPY (FINAL): YELLOW OWNER COPY (INITIAL): PINK