IREDELL COUNTY HEALTH DEPARTMENT

STATESVILLE 704-878-5305 MOORESVILLE 704-664-5281

IMPROVEMENT PERMIT / AUTHORIZATION TO CONSTRUCT / OPERATION PERMIT / EXISTING SYSTEM INSPECTION

PERMIT# 120970 PIN# 4638 45 8528

OWNER OR CONTRACTOR C+S Construction DATE 5/10/04

ADDRESS 125 Coal Creek Ln. Mt Ulla, NC. 28125 PHONE: Business 704-664-3290 Home

LOCATION Perth Rd N to Normandy Rd. on (R) # 292 Normandy Rd.

SUBDIVISION C L + T BLOCK / SECTION 11 LOT 84A LOT AREA .91A SITE CLASS. DESIGN FLOW 360 gals L.T.A.R.

Septic Tank: EXISTING Gallons; STB Date

Pump Tank: Gallons; PT Date

Pump Make: Model Serial No.

Nitrification Field: No Fields Square Feet 562 Linear Feet

No Lines Trench Width EXISTING Max Trench Bottom Depth Gravel Depth

☐ New System ☐ Repair System Type: I, II, III, IV, V, VI

System Description: EXISTING BED 112'X5'

Repair System Description:

Maintenance Agreement Required: ☐ Yes ☒ No

☐ House/Mod. Home No. Bedrooms 3

☒ Mobile Home No. Bathrooms 2

☐ Business No. Employees

☐ Other

☐ Slab ☒ Crawl Space ☐ Basement w/plumbing ☐ Basement wo/plumbing


Water Supply: ☐ Individual ☐ Public ☐ Community

Comments:/Conditions:

INITIAL SITE SKETCH

Comments:/Conditions:

AS BUILT SKETCH

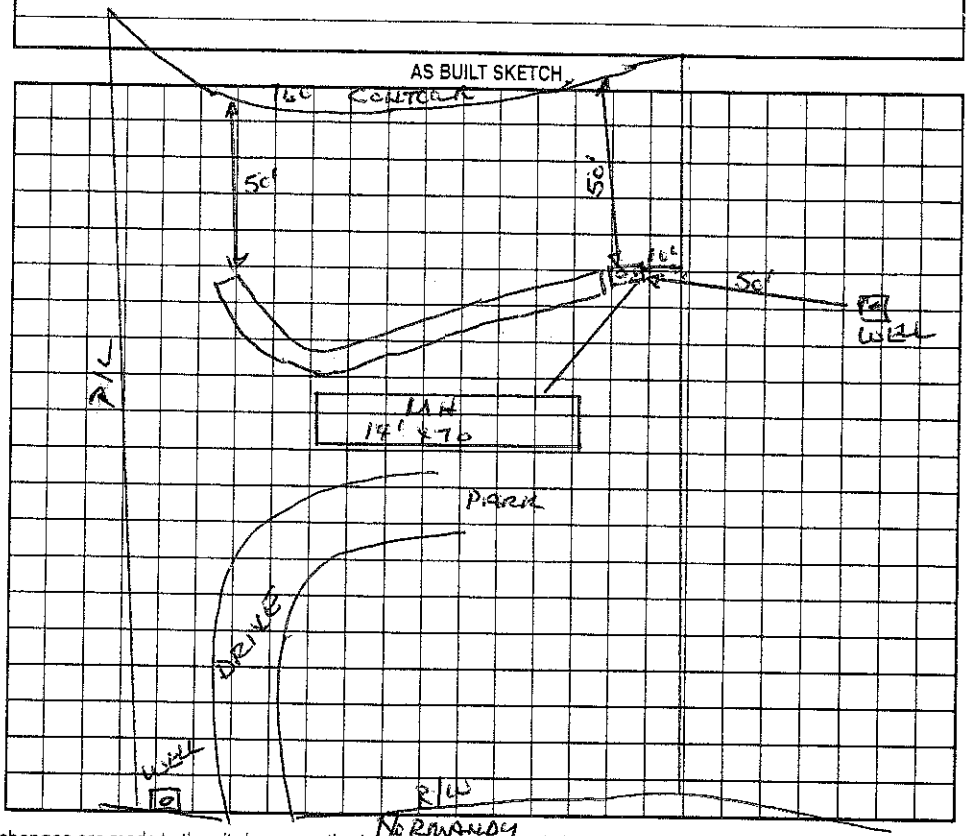

Permit can be suspended or revoked if any false information is supplied toward securing the permit/any unauthorized changes are made to the site/any unauthorized changes are made in the installation of the system. Improvement Permit with plat valid without expiration. Improvement Permit with site plan valid for sixty months. Authorization to Construct is valid for a period equal to that of Improvement Permit – not to exceed sixty months.

Signed: Paul Combs date 5-13-04 Installed by:

Improvement Permit by: date Operation Permit by: date

Authorization to Construct by: date Existing System Inspection by: Wesley Sparks RS. date 5/10/04

HEALTH DEPT. COPY: WHITE OWNER COPY (FINAL): YELLOW OWNER COPY (INITIAL): PINK