IREDELL C[illegible] HEALTH DEPARTMENT

STATESVILLE 704-878-5305 MOORESVILLE 704-664-5281

IMPROVEMEN[illegible] ERMIT / AUTHORIZATION TO CONSTRUCT / OPERATION PERMIT / EXISTING SYSTEM INSPECTION

PERMIT# Repair PIN# 4638478774 DATE 2/5/03

OWNER OR CONTRACTOR Roger Burroughs PHONE: Business (704)361-4307 Home

ADDRESS 134 Folkstone Rd Mooresville NC 28117

LOCATION Perth, TL Stumpy Crk, TL Collingswood, TR Folkstone on Rt #134

SUBDIVISION CC&T BLOCK / SECTION 14 LOT 99 LOT AREA 0.99Ac SITE CLASS PS DESIGN FLOW 360 L.T.A.R. —

Septic Tank: 1000 Gallons; STB 794 Date 2/26/03

Pump Tank: Gallons; PT Date

Pump Make: Model Serial No.

Nitrification Field: No Fields 1 Square Feet 900 Linear Feet 300

No Lines 3@100' Trench Width 36" Max Trench Bottom Depth 36" Gravel Depth —

☐ New System ☒ Repair System Type: I, II, (III), V, V, VI

System Description:

Repair System Description: Gravity 25% Red.

Maintenance Agreement Required: ☐ Yes ☐ No

☒ House/Mod. Home ☐ Mobile Home ☐ Business ☐ Other

No. Bedrooms 3 No. Bathrooms 2 No. Employees

☐ Slab ☒ Crawl Space ☐ Basement w/plumbing ☐ Basement wo/plumbing

Water Supply: ☒ Individual ☐ Public ☐ Community Existing


Comments:/Conditions:

Install Drain lines on contour


Comments:/Conditions:

E-Z Flow Installed 3@100'

INITIAL SITE SKETCH

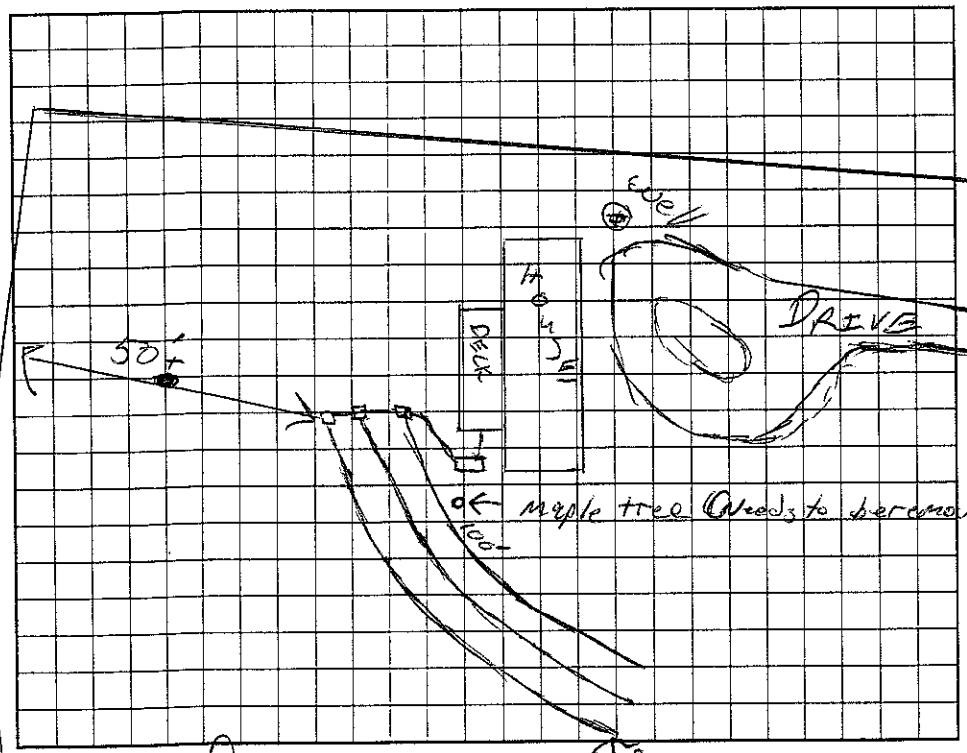

AS BUILT SKETCH

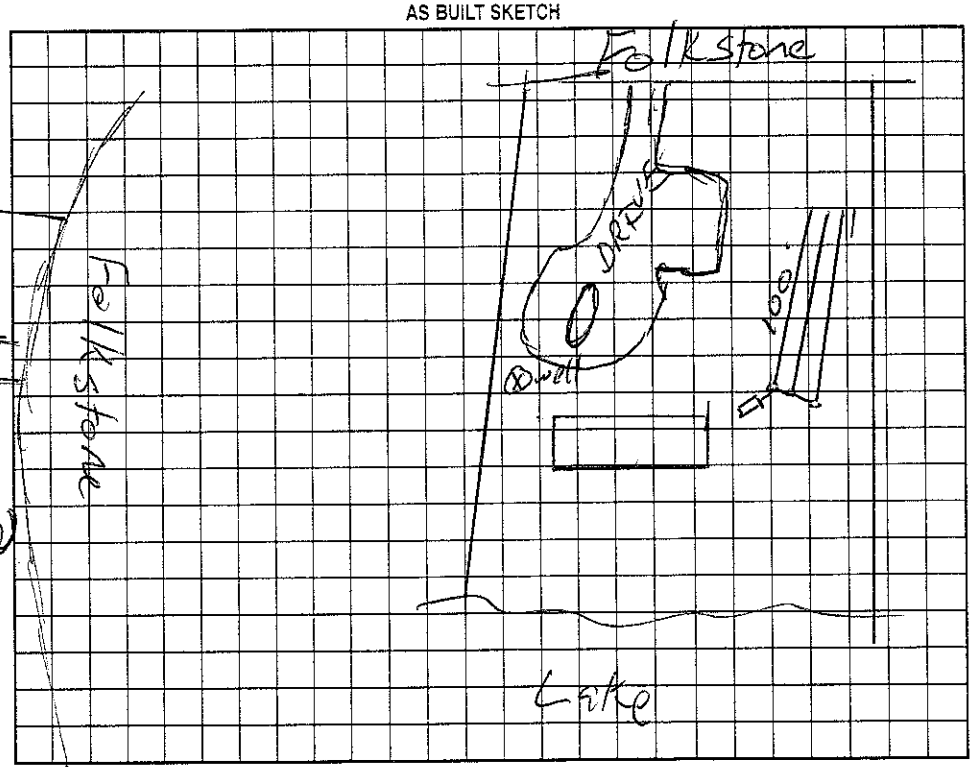

~~Permit can be suspended or revoked if any false information is supplied toward securing the permit/any unauthorized changes are made to the site/any unauthorized changes are made in the installation of the system.~~ Improvement Permit with plat valid without expiration. Improvement Permit with site plan valid for sixty months. Authorization to Construct is valid for a period equal to that of Improvement Permit – not to exceed sixty months.

Signed: date

Improvement Permit by: RS date 2/3/03

Authorization to Construct by: RS date 3/3/03

Installed by: Specialty Septic (Larry Tucker)

Operation Permit by: RS date 3/25/03

Existing System Inspection by: date

HEALTH DEPT. COPY: WHITE OWNER COPY (FINAL): YELLOW OWNER COPY (INITIAL): PINK