IREDELL COUNTY HEALTH DEPARTMENT

Statesville Office (704) 878-5305 Mooresville Office (704) 660-3625 PERMIT # 203480

IMPROVEMENT PERMIT / AUTHORIZATION TO CONSTRUCT / OPERATION PERMIT / EXISTING SYSTEM

PIN # 4638-49-7210

APPLICANT: DONNA SANDERSON APPLICANT ADDRESS: 120 SENECA PL.

SITE ADDRESS: SAME PHONE: 704-528-4028 ALT. PHONE:

SITE DIRECTIONS: PERTH, STUMPY CK, T R C BOAT LANDING, TL SENECA

SUBDIVISION: CL&T SECTION: 14 LOT # 105 LOT AREA: .84 AC DESIGN FLOW: — L.T.A.R.: —

Septic Tank EXISTING (gal) STB Date

Pump Tank (gal) PT Date

Pump Make Model Serial #

Nitrification Fields # Lines EXISTING Linear Ft:

Trench Width Max. Trench Bottom Depth Gravel Depth

☐ New System ☐ Repair ☐ Expansion System Type: (II) III IV V VI

System Description: GRAVEL

Repair System Description:

Maintenance Agreement Required: ☐ YES ☒ NO

☒ GRAVITY ☐ PRESSURE

☐ Residence No. Bedrooms

☐ Business No. Persons

☒ Other No. Employees

☒ Slab ☐ Crawl Space

☐ Basement w/plumbing ☐ Basement w/o plumbing

Water Supply: ☐ Private ☐ Public ☒ Community

Comments / Conditions:

GARAGE


INITIAL SITE SKETCH

WATER FROM COMMUNITY WELL.

GARAGE APPEARS TO MEET SETBACK TO EXISTING SEPTIC SYSTEM.

AS BUILT SKETCH

1" = 50'

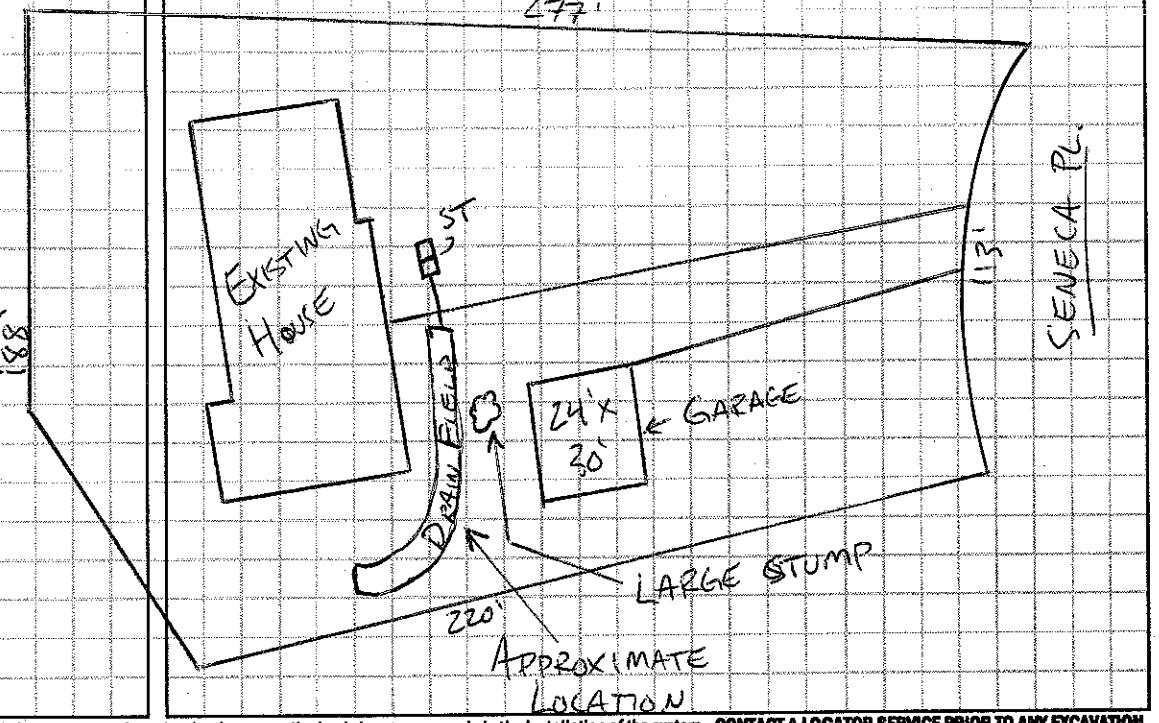

Permit can be suspended or revoked if any false information is supplied toward securing the permit / any unauthorized changes are made to the site / any unauthorized changes are made in the installation of the system. **CONTACT A LOCATOR SERVICE PRIOR TO ANY EXCAVATION**

☐ **IMPROVEMENT PERMIT** *with plat valid without expiration.* ☐ **IMPROVEMENT PERMIT** *with site plan valid for 60 mos.* ☐ **AUTHORIZATION TO CONSTRUCT** *valid for period equal to IMPROVEMENT PERMIT--not to exceed 60 mo.*

Owner / Applicant Signature: Donna L Sanderson Date: 8-21-14 Installed by:

IMPROVEMENT PERMIT by: Date: OPERATION PERMIT by: Date:

AUTHORIZATION TO CONSTRUCT by: Date: Existing System Inspected by: Date: 8-19-14

Health Dept. Copy - WHITE Applicant (Final Approval) - YELLOW Applicant (Conditional Approval) - PINK