IREDELL COUNTY HEALTH DEPARTMENT

STATESVILLE 704-878-5305 MOORESVILLE 704-664-5281

IMPROVEMENT PERMIT / AUTHORIZATION TO CONSTRUCT / OPERATION PERMIT / EXISTING SYSTEM INSPECTION

PERMIT# 139008 PIN# 4638498696 DATE 12-6-06

OWNER OR APPLICANT E.F. Muise / Charlie Rowe PHONE: Business 704-663-7779 Home

ADDRESS 136 Stutts Rd Mooresville Address: 123 Dearborn Ln.

LOCATION 21 N TL Cornelius Rd cross Perth to Liva Ln TL Stumpy Creek TR Dearborn on right

SUBDIVISION C L & T BLOCK / SECTION 14 LOT 112 LOT AREA .81 Ac SITE CLASS. PS DESIGN FLOW 480gpd L.T.A.R. .3 gpd/ft²

Septic Tank: 1000 Gallons; STB 1007 Date 3-20-07
Pump Tank: 1000 Gallons; PT 274 Date 2-15-07
Pump Make: Zoeller Model N 152 Serial No.
Nitrification Field: No Fields 1 Square Feet Linear Feet 270
No Lines 4 Trench Width 24" Max Trench Bottom Depth 36" Gravel Depth NA ☐ Gravity ☒ Pressure

☒ New System ☐ Repair ☐ Expansion System Type: I II III (IV) V VI
System Description: LP Panel
Repair System Description: LP Panel
Maintenance Agreement Required: ☒ Yes ☐ No

☒ House/Mod. Home No. Bedrooms 4
☐ Mobile Home No. Persons 8
☐ Business No. Employees
☐ Other


Water Supply: ☒ Individual ☐ Public ☐ Community

☐ Slab ☒ Crawl Space ☒ Basement w/plumbing ☐ Basement wo/plumbing

Comments/Conditions: Plumbing from basement to be pumped to first floor
Sleeve supply line under driveway
House moved to 55' off Lake/Property Line

Comments/Conditions: Checked ST & PT & uppermost line (Drilled 3/16" hole)
Note: Tanks installed in front of Exist house, will probably need to move Tanks for future Construction.

1"=60' INITIAL SITE SKETCH # Panels: 62

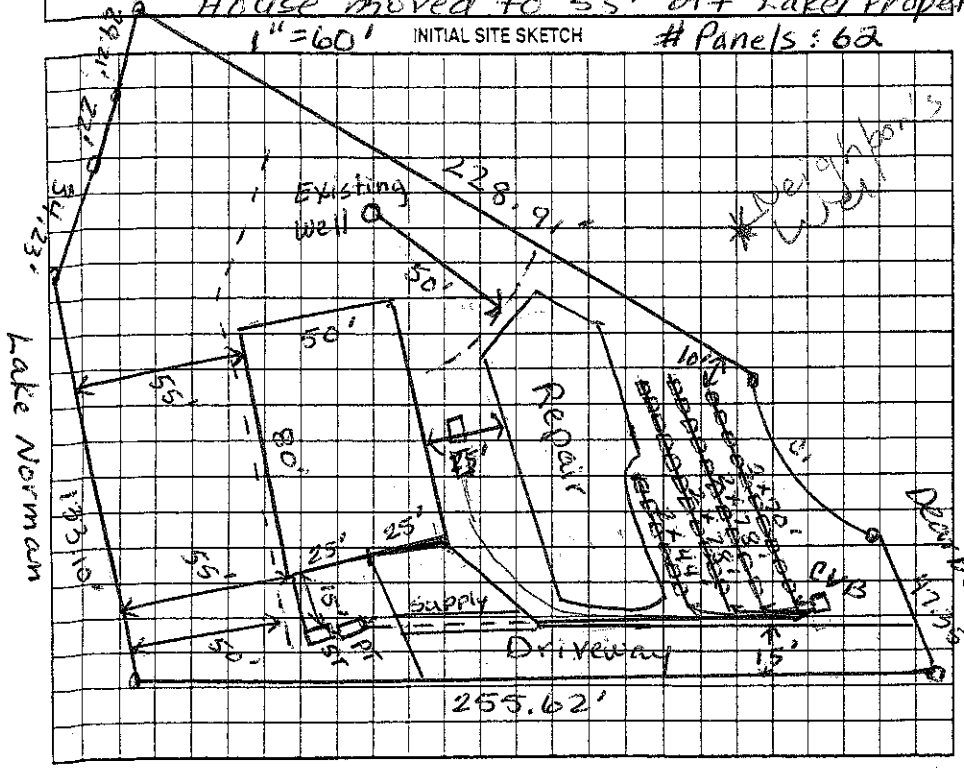

AS BUILT SKETCH

5/29/07 Checked other drain 58/62

Checked Supply line set pressure @ 25#

Permit can be suspended or revoked if any false information is supplied toward securing the permit/any unauthorized changes are made to the site/any unauthorized changes are made in the installation of the system. Improvement Permit with plat valid without expiration ☐ Improvement Permit with site plan valid for sixty months ☒ Authorization to Construct is valid for a period equal to that of Improvement Permit – not to exceed sixty months.

Signed: E. F. Muise date 12-19-06 Installed by: Wayne Clontz RS

Improvement Permit by: Judy McAuliffe date 12-6-06 Operation Permit by: Maria H. Dolan RS date 6/7/07

Authorization to Construct by: Maria H. Dolan RS date 5/22/06 Existing System Inspection by: date

HEALTH DEPT. COPY: WHITE OWNER COPY (FINAL): YELLOW OWNER COPY (INITIAL): PINK