10

IREDELL COUNTY HEALTH DEPARTMENT

STATESVILLE 704-878-5305 MOORESVILLE 704-664-5281

IMPROVEMENT PERMIT / AUTHORIZATION TO CONSTRUCT / OPERATION PERMIT / EXISTING ~~SYSTEM~~ INSPECTION

PERMIT# 139008 PIN# 4638498696 DATE 12-6-06

OWNER OR APPLICANT E. F. Muise / Charlie Rowe PHONE: Business 704-663-7779 Home

ADDRESS 136 Stutts Rd Mooresville

LOCATION 21 N TL Cornelius Rd Cross Perth to Liva Ln TL Stumpy Creek TR Dearborn on right

Address: 123 Dearborn Ln.

SUBDIVISION C L & T BLOCK / SECTION 14 LOT 112 LOT AREA .81 Ac. SITE CLASS. PS DESIGN FLOW 480gpd L.T.A.R. .3 gpd / ft²

Septic Tank: 1000 Gallons; STB 1007 Date 3-20-07

Pump Tank: 1000 Gallons; PT 274 Date 2-15-07

Pump Make: Zoeller Model N 152 Serial No.

Nitrification Field: No Fields 1 Square Feet Linear Feet 270

No Lines 4 Trench Width 24" Max Trench Bottom Depth 36" Gravel Depth NA ☐ Gravity ☒ Pressure ☐ Slab ☒ Crawl Space ☒ Basement w/plumbing ☐ Basement wo/plumbing

☒ New System ☐ Repair ☐ Expansion System Type: I II III (IV) V VI

System Description: LP Panel

Repair System Description: LP Panel

Maintenance Agreement Required: ☒ Yes ☐ No

☒ House/Mod. Home No. Bedrooms 4

☐ Mobile Home No. Persons 8


☐ Business No. Employees

☐ Other

Water Supply: ☒ Individual ☐ Public ☐ Community

Comments/Conditions: Plumbing from basement to be pumped to first floor
Sleeve supply line under driveway
House moved to 55' off Lake/Property Line

1"=60' INITIAL SITE SKETCH # Panels: 62

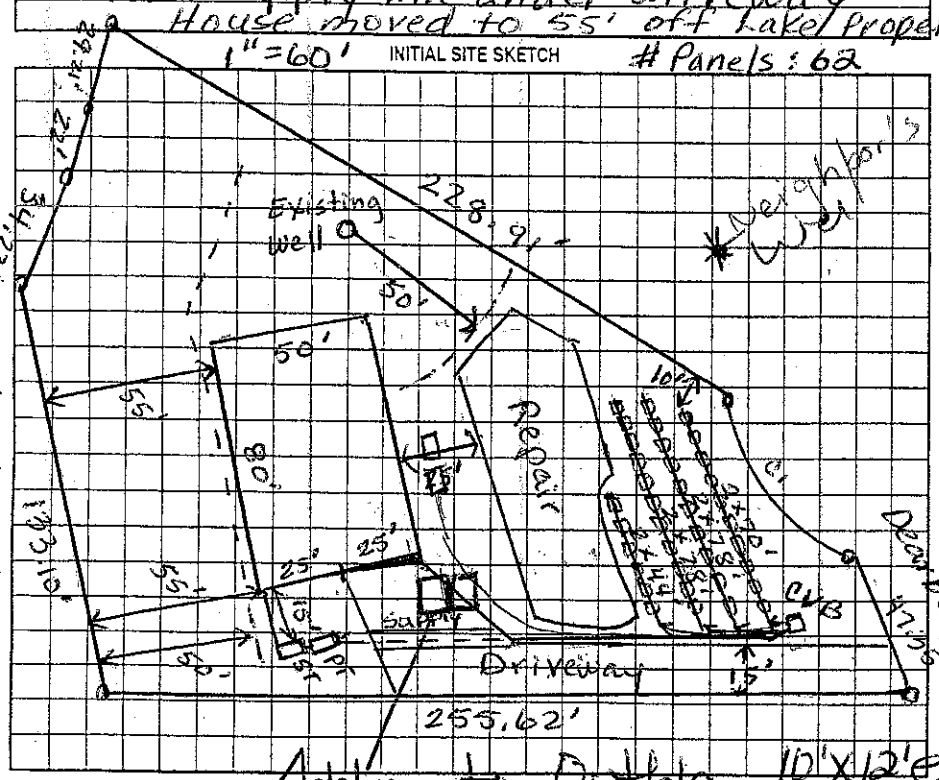

Adding 10 Outbldg 10'X12' Ea.

Comments/Conditions: Checked ST & PT & uppermost Line (Drilled 3/16" hole)
Note: Tanks installed in front of Exist house, will probably need to move tanks for future Construction.

AS BUILT SKETCH

5/29/07 Checked other drain

58
62

Checked Supply line set pressure @ 25#

The proposed / existing Outbuildings/Sheds addition does not appear to impact the existing septic system
**NOTE: Keep Buildings at least 5ft from Septic

Mary Dotson REHS
Date: 5/27/2011
ICHD-Environmental Health Division

Permit can be suspended or revoked if any false information is supplied toward securing the permit/any unauthorized changes are made to the site/any unauthorized changes are made in the installation of the system. Improvement Permit with plat valid without expiration. ☐ Improvement Permit with site plan valid for sixty months ☒ Authorization to Construct is valid for a period equal to that of Improvement Permit – not to exceed sixty months.

Signed: E. F. Muise date 12-14-06

Improvement Permit by: Judy McNeill date 12-6-06

Authorization to Construct by: Mary H. Dotson RS date 5/22/06

Installed by: Wayne Clontz RS date 6/7/07

Operation Permit by: Mary H. Dotson

Existing System Inspection by: date

HEALTH DEPT. COPY: WHITE OWNER COPY (FINAL): YELLOW OWNER COPY (INITIAL): PINK