IREDELL COUNTY HEALTH DEPARTMENT

STATESVILLE 704-878-5305 MOORESVILLE 704-664-5281

IMPROVEMENT PERMIT / AUTHORIZATION TO CONSTRUCT / OPERATION PERMIT / EXISTING SYSTEM INSPECTION

PERMIT# 115323 PIN# 4638 49 9286 DATE 9/10/03

OWNER OR CONTRACTOR Patricia & Thomas Wright PHONE: Business Home 704-763-5396

ADDRESS 9500 Mt Rose Rd. Charlotte NC. 28216 (110 Seneca Pl.)

LOCATION Perth Rd. N TL Stumpy Creek Rd. TR. Stumpy Creek TL Seneca Place, 1st drive on (R)

SUBDIVISION CL+T BLOCK / SECTION 14 LOT 107 LOT AREA SITE CLASS. DESIGN FLOW L.T.A.R.

Septic Tank: EXISTING Gallons: STB Date

Pump Tank: Gallons: PT Date

Pump Make: Model Serial No.

Nitrification Field: No Fields Square Feet EXISTING Linear Feet

No Lines Trench ~~Width~~ Max Trench Bottom Depth Gravel Depth

☐ New System ☐ Repair System Type: I (II) III, IV, V, VI

System Description: GRAVITY - BED

Repair System Description: PRESSURE - 16" PPBPS

Maintenance Agreement Required: ☐ Yes ☒ No

☒ House/Mod. Home No. Bedrooms 3

☐ Mobile Home No. Bathrooms 1

☐ Business No. Employees

☐ Other

☐ Slab ☒ Crawl Space ☐ Basement w/plumbing ☐ Basement wo/plumbing


Water Supply: ☒ Individual ☐ Public ☐ Community

Comments:/Conditions:


Comments:/Conditions:

Existing System.

INITIAL SITE SKETCH

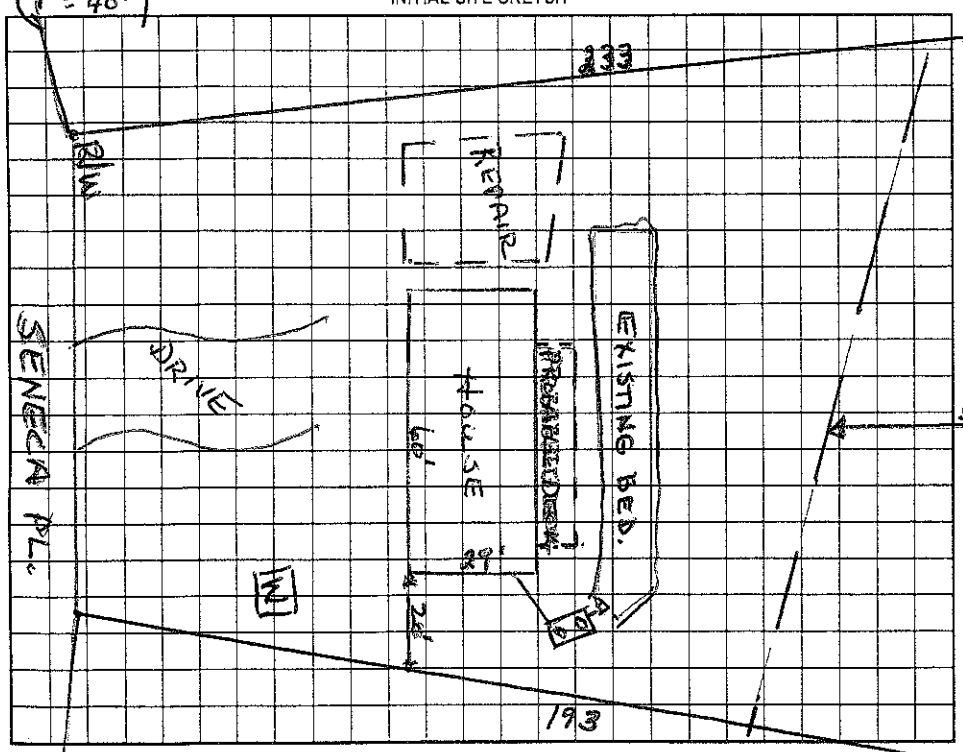

AS BUILT SKETCH

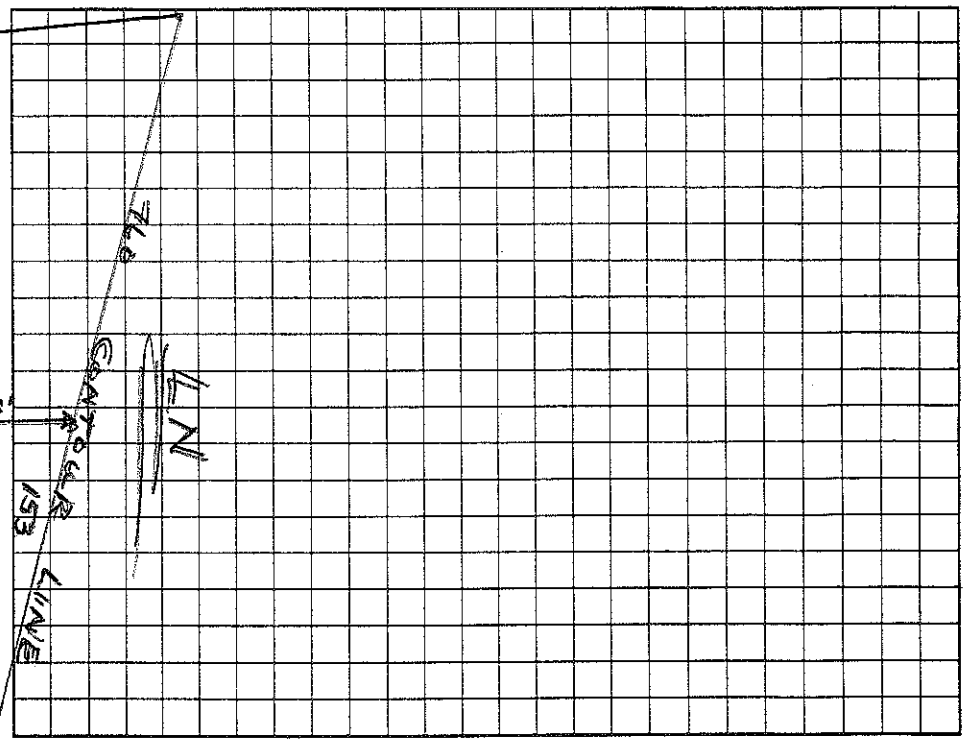

Permit can be suspended or revoked if any false information is supplied toward securing the permit/any unauthorized changes are made to the site/any unauthorized changes are made in the installation of the system. Improvement Permit with plat valid without expiration. Improvement Permit with site plan valid for sixty months. Authorization to Construct is valid for a period equal to that of Improvement Permit – not to exceed sixty months.

Signed: X date 9-11-03 Installed by:

Improvement Permit by: date Operation Permit by: date

Authorization to Construct by: date Existing System Inspection by: Wesley Sparks RS. date 9/10/03

HEALTH DEPT. COPY: WHITE OWNER COPY (FINAL): YELLOW OWNER COPY (INITIAL): PINK