3:30

IREDELL COUNTY HEALTH DEPARTMENT

Statesville Office (704) 878-5305 Mooresville Office (704) 660-3625 PERMIT # 142288

IMPROVEMENT PERMIT / AUTHORIZATION TO CONSTRUCT / OPERATION PERMIT / EXISTING SYSTEM

PIN # 4638522810

APPLICANT: Robert Guido APPLICANT ADDRESS: 133 N. Audubon Ave Mooresville, NC

SITE ADDRESS: 110 Airplane Ct. Mooresville, NC 28117 PHONE: 704 604-6366 ALT. PHONE: 704 696 0466

SITE DIRECTIONS: Perth Rd. N. TC Normandy TC Airplane Ct 1st lot on right

SUBDIVISION: Lake Norman Air Park SECTION: 7 LOT # 4 LOT AREA: DESIGN FLOW: 600gpd L.T.A.R.: .3+

Septic Tank 1500 (gal) STB 964 Date 6-26-13 — ☒ New System ☐ Repair ☐ Expansion System Type: I II III IV V VI — ☒ Residence No. Bedrooms 5 — Water Supply: ☒ Private

Pump Tank (gal) PT Date — System Description: Gravity - 25% Reduction — ☐ Business No. Persons — ☐ Public

Pump Make Model Serial # — Repair System Description: Gravity + 25% to 50% Reduct — ☐ Other No. Employees — ☐ Community

Nitrification Fields 1 # Lines 5 Linear Ft: 500 — Maintenance Agreement Required: ☐ YES ☒ NO — ☐ Slab ☒ Crawl Space — ☐ Basement w/plumbing ☐ Basement w/o plumbing


Trench Width 36" Max. Trench Bottom Depth 36" Gravel Depth N/A — ☒ GRAVITY ☐ PRESSURE

Shop

Comments / Conditions: Keep Septic System 100ft from Well. Future Pool must be at least 15ft from Septic.

* Direct storm/surface water away from Septic Areas.

INITIAL SITE SKETCH

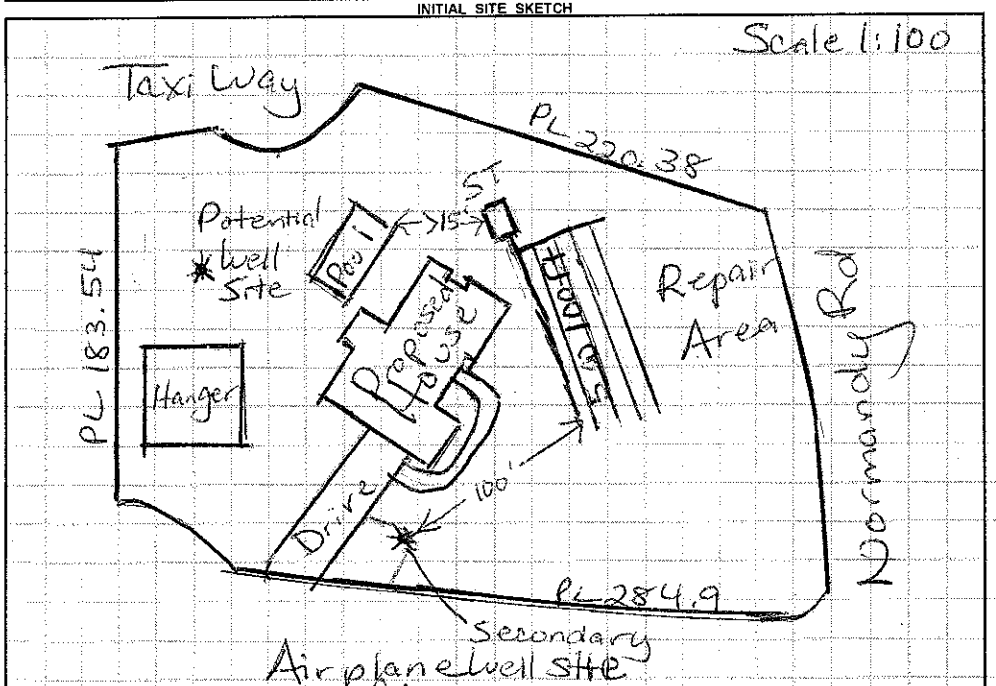

AS BUILT SKETCH

Used Quick 4 for Drainfield
Installed essentially as Drawn

Permit can be suspended or revoked if any false information is supplied toward securing the permit / any unauthorized changes are made to the site / any unauthorized changes are made in the installation of the system. **CONTACT A LOCATOR SERVICE PRIOR TO ANY EXCAVATION**

☐ **IMPROVEMENT PERMIT** *with plat valid without expiration.* ☐ **IMPROVEMENT PERMIT** *with site plan valid for 60 mos.* ☐ **AUTHORIZATION TO CONSTRUCT** *valid for period equal to IMPROVEMENT PERMIT--not to exceed 60 mo.*

Owner / Applicant Signature: Date: Installed by: Groundbreaker

IMPROVEMENT PERMIT by: RS Date: 5/21/13 OPERATION PERMIT by: Date: 10/21/13

AUTHORIZATION TO CONSTRUCT by: BS Date: 5/21/13 Existing System Inspected by: Date:

Health Dept. Copy - WHITE Applicant (Final Approval) - YELLOW Applicant (Conditional Approval) - PINK

3:30

IREDELL COUNTY HEALTH DEPARTMENT

Statesville Office (704) 878-5305 Mooresville Office (704) 660-3625 PERMIT # 142288

IMPROVEMENT PERMIT / AUTHORIZATION TO CONSTRUCT / OPERATION PERMIT / EXISTING SYSTEM

PIN # 4638522810

APPLICANT: Robert Guido APPLICANT ADDRESS: 133 N. Audubon Ave Mooresville, NC

SITE ADDRESS: 110 Airplane Ct. Mooresville, NC 28117 PHONE: 704 604-6366 ALT. PHONE: 704 696 0466

SITE DIRECTIONS: Perth Rd. N. TL Normandy TL Airplane Ct. 1st lot on right

SUBDIVISION: Lake Norman Air Park SECTION: 7 LOT # 4 LOT AREA: DESIGN FLOW: 600 gpd L.T.A.R.: .3+

Septic Tank 1500 (gal) STB 964 Date 6-26-13 — New System ☐ Repair ☐ Expansion System Type: I ☐ II ☐ III ☒ IV ☐ V ☐ VI

Pump Tank (gal) PT Date — System Description: Gravity -- 25% Reduction

Pump Make Model Serial # — Repair System Description: Gravity +25% to 50% Reduct

Nitrification Fields 1 # Lines 5 Linear Ft: 500 — Maintenance Agreement Required: ☐ YES ☒ NO

Trench Width 36" Max. Trench Bottom Depth 36" Gravel Depth N/A — ☒ GRAVITY ☐ PRESSURE

☒ Residence No. Bedrooms 5 — Water Supply: ☒ Private ☐ Public ☐ Community

☐ Business No. Persons

☐ Other No. Employees


☐ Slab ☒ Crawl Space

☐ Basement w/plumbing ☐ Basement w/o plumbing

Comments / Conditions: Keep Septic System 100ft from well. Future Pool must be at least 15ft from Septic.

* Direct storm/surface water away from Septic areas.

INITIAL SITE SKETCH

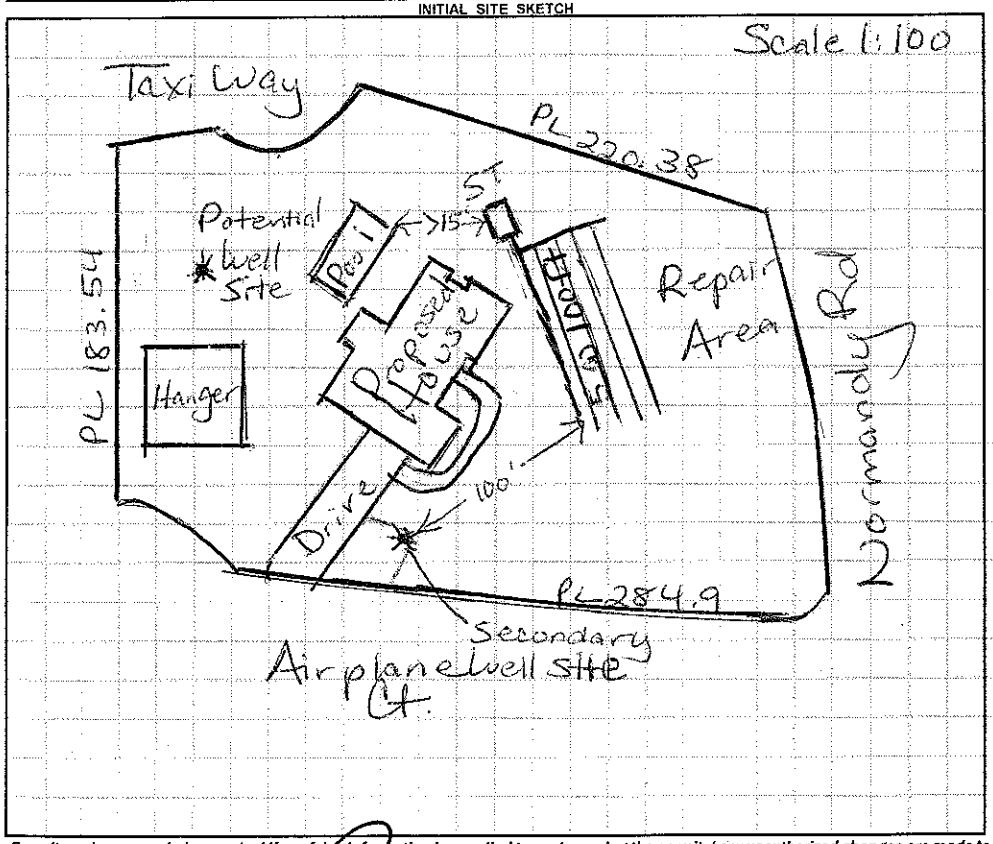

AS BUILT SKETCH

Used Quick 4 for Drainfield
Installed essentially as Drawn

Permit can be suspended or revoked if any false information is supplied toward securing the permit / any unauthorized changes are made to the site / any unauthorized changes are made in the installation of the system. **CONTACT A LOCATOR SERVICE PRIOR TO ANY EXCAVATION**

☐ **IMPROVEMENT PERMIT** *with plat valid without expiration.* ☐ **IMPROVEMENT PERMIT** *with site plan valid for 60 mos.* ☐ **AUTHORIZATION TO CONSTRUCT** *valid for period equal to IMPROVEMENT PERMIT--not to exceed 60 mo.*

Owner / Applicant Signature: Date:

IMPROVEMENT PERMIT by: RS Date: 5/21/13

AUTHORIZATION TO CONSTRUCT by: RS Date 5/21/13

Installed by: Groundbreaker

OPERATION PERMIT by: Date: 10/21/13

Existing System Inspected by: Date:

Health Dept. Copy - WHITE Applicant (Final Approval) - YELLOW Applicant (Conditional Approval) - PINK