IREDELL COUNTY HEALTH DEPARTMENT

STATESVILLE 704-878-5305 MOORESVILLE 704-664-5[illegible]

IMPROVEMENT PERMIT / ~~CERTIFICATE OF COMPLETION~~ / OPERATION PERMIT / EXISTING SYSTEM INSPECTION

PROPERTY DESCRIPTION NO. 17957 DATE 8/4/95 TAX MAP NO. 2P A 14A Watershed: ☐ Yes ☒ No

OWNER OR CONTRACTOR Allen Bond PHONE: Business _____ Home 662-9282

ADDRESS 115 Cobblestone Ln. Mooresville, NC. 28115

LOCATION Normandy Rd (L) on Kistler Rd. to L on (L) corner

SUBDIVISION LNAP BLOCK / SECTION IV LOT 37 LOT AREA 2.58 SITE CLASS. PS DESIGN FLOW 360 L.T.A.R. .35

Septic Tank: 1000 Gallons; STB 794 Date 9/13/95
Pump Tank: _____ Gallons; PT _____ Date _____
Pump Make: _____ Model _____ Serial No. _____
Nitrification Field: No Fields 1 Square Feet 1027 Linear Feet 270 (342)
No Lines 3 Trench Width 36" Max Trench Bottom Depth 36" Gravel Depth N/A

☒ New System ☐ Repair System Type: I, II, III, IV, V, VI
System Description: INFILTRATOR - O/Bck
Repair System Description: _____
Maintenance Agreement Required: ☐ Yes ☒ No


☒ House/Mod. Home No. Bedrooms 3
☐ Mobile Home No. Bathrooms 2.5
☐ Business No. Employees _____
☐ Other _____
☐ Slab ☒ Crawl Space ☐ Basement w/plumbing ☐ Basement wo/plumbing

Water Supply:
☒ Individual
☐ Community
☐ Public

Comments:

REPAIR AREA

INITIAL SITE SKETCH

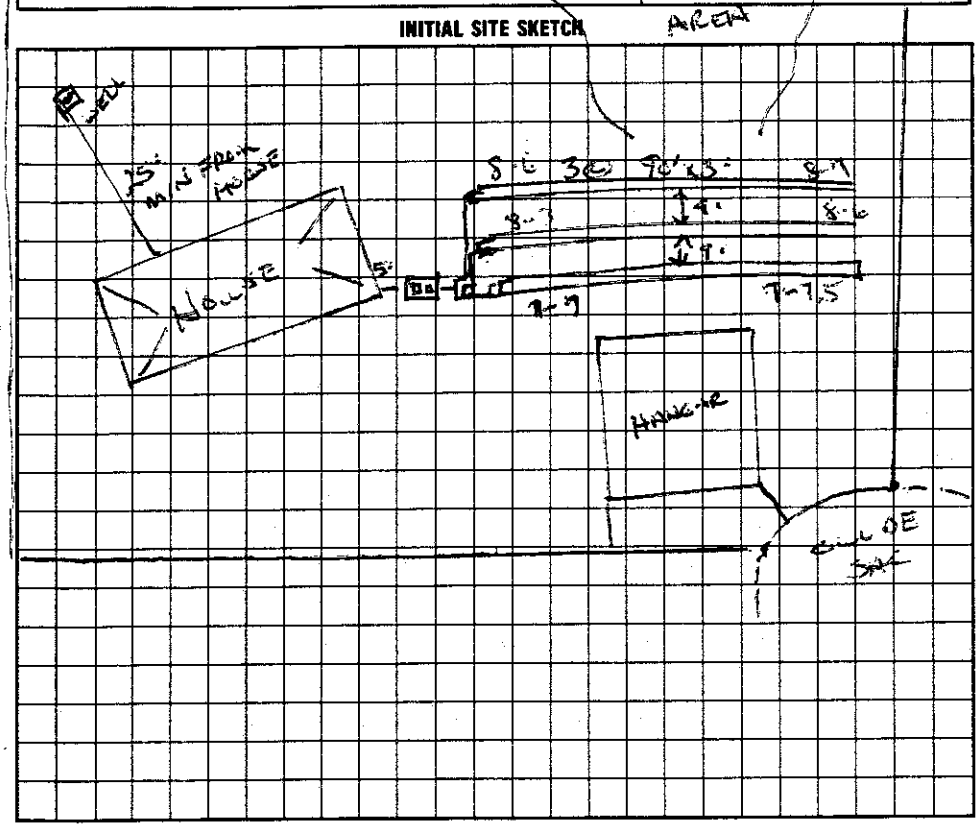

Comments:

clustered system on dry plant.

AS BUILT SKETCH

I understand that this permit can be suspended or revoked if any false information is supplied toward securing the permit/any unauthorized changes are made to the site/any unauthorized changes are made in the installation of the system.

Signed: _____

Improvement Permit by: Wesley Sparks RS date 8/4/95

Existing System Inspection by: _____ date _____

Installed by: Brown Const. Co.

Certificate of Completion by: _____ date _____

Operation Permit by: Wesley Sparks RS date 10/17/95

HEALTH DEPT. COPY: WHITE INSPECTION COPY (FINAL): GREEN OWNER COPY (FINAL): YELLOW INSPECTION COPY (INITIAL): PINK OWNER COPY (INITIAL): GOLD