IREDELL COUNTY HEALTH DEPARTMENT

STATESVILLE 704-878-5305 MOORESVILLE 704-664-5281

IMPROVEMENT PERMIT / CERTIFICATE OF COMPLETION / OPERATION PERMIT / EXISTING SYSTEM INSPECTION

PROPERTY DESCRIPTION NO. 17958 DATE 11/22/94 TAX MAP NO. 2PA 14A

OWNER OR CONTRACTOR Brown Newbill PHONE: Business 4638-52-5665 Home 483-4649 Watershed: ☐ Yes ☑ No

ADDRESS 7769 Bellinger Rd. Denver, NC. 28037

LOCATION Ruston. RD., Normandy ⓛ on Ruston Rd to 2nd lot on ⓡ

SUBDIVISION LN Air Park BLOCK / SECTION II LOT 38 LOT AREA 1.47 Ac. SITE CLASS. P. DESIGN FLOW 360 L.T.A.R. 335

Septic Tank: 1000 Gallons; STB 794 Date 11/16/95

Pump Tank: ____ Gallons; PT ____ Date ____

Pump Make: ____ Model ____ Serial No. ____

Nitrification Field: No Fields 1 Square Feet 1200 Linear Feet 400

No Lines 4 Trench Width 36" Max Trench Bottom Depth 32" Gravel Depth 12"

☑ New System ☐ Repair System Type: I, (II), III, IV, V, VI

System Description: CONV - DIST BOX-SPEEDLINE

Repair System Description: PRES. PANEL

Maintenance Agreement Required: ☐ Yes ☑ No

☑ House/Mod. Home ☐ Mobile Home ☐ Business ☐ Other


No. Bedrooms 3 No. Bathrooms 2.5 No. Employees ____

☐ Slab ☑ Crawl Space ☐ Basement w/plumbing ☐ Basement wo/plumbing

Water Supply: ☑ Individual ☐ Community ☐ Public

Comments: Keep trench lines on contour as close shown. Repair area must be maintained. TACT WAY 227

INITIAL SITE SKETCH

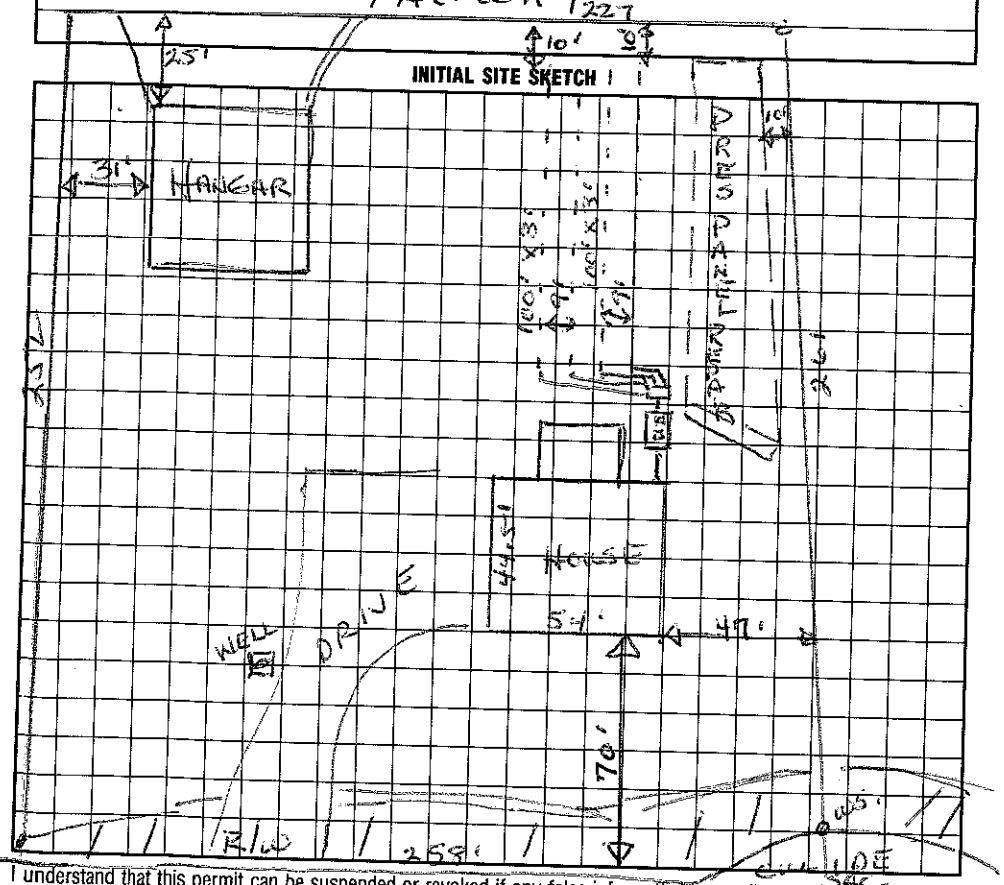

Comments: Installed as shown on disp. Permit

AS BUILT SKETCH

I understand that this permit can be suspended or revoked if any false information is supplied toward securing the permit/any unauthorized changes are made to the site/any unauthorized changes are made in the installation of the system. Improvement Permit is valid for 60 months from date of issuance.

Signed: Brenda Ruston RD.

Improvement Permit by: Wesley Sparks RS. date 11/22/94

Existing System Inspection by: ____ date ____

Installed by: Brown Const. Co.

Certificate of Completion by: ____ date ____

Operation Permit by: Wesley Sparks RS. date 4/9/96

HEALTH DEPT. COPY: WHITE INSPECTION COPY (FINAL): GREEN OWNER COPY (FINAL): YELLOW INSPECTION COPY (INITIAL): PINK OWNER COPY (INITIAL): GOLD