Aloha Pools

4:00

IREDELL COUNTY HEALTH DEPARTMENT

STATESVILLE 704-878-5305 MOORESVILLE 704-664-5281

IMPROVEMENT PERMIT / AUTHORIZATION TO CONSTRUCT / OPERATION PERMIT / EXISTING SYSTEM INSPECTION

PERMIT# 141535 PIN# 4638530052

OWNER OR APPLICANT Tracy Adams / Pride Homes (Matt (Pride)) PHONE: Business 361-8528 Home 660-5061 DATE 5-4-07

ADDRESS 830 Big Indian Loop Mooresville, NC 28117

LOCATION Perth Rd N TL Normandy TL Airplane Ct on left

SUBDIVISION Lk Norman Airpk BLOCK / SECTION ____ LOT 1 LOT AREA 1.68 Acre SITE CLASS. PS DESIGN FLOW 600 gpd T.A.R. .25 to .3

Septic Tank: 1500 Gallons; STB 528 Date 7/20/04

Pump Tank: ____ Gallons; PT ____ Date ____

Pump Make: ____ Model ____ Serial No. ____

Nitrification Field: No Fields 1 Square Feet 1800' Linear Feet 600'

No Lines 6 @ 100' Trench Width 36" Max Trench Bottom Depth 36" Gravel Depth N/A

☒ New System ☐ Repair ☐ Expansion System Type: I II III IV V VI

System Description: Gravity - 25% Reduction

Repair System Description: Pump Grav - 50% - 25%

Maintenance Agreement Required: ☐ Yes ☒ No Reduct

☒ House/Mod. Home ☐ Mobile Home ☐ Business ☐ Other

No. Bedrooms 2 No. Persons ____ No. Employees ____


Water Supply: ☒ Individual ☐ Public ☐ Community

☐ Gravity ☐ Pressure ☐ Slab ☐ Crawl Space ☐ Basement w/plumbing ☐ Basement wo/plumbing

Comments/Conditions: PL 17.68


INITIAL SITE SKETCH

Scale 1:60

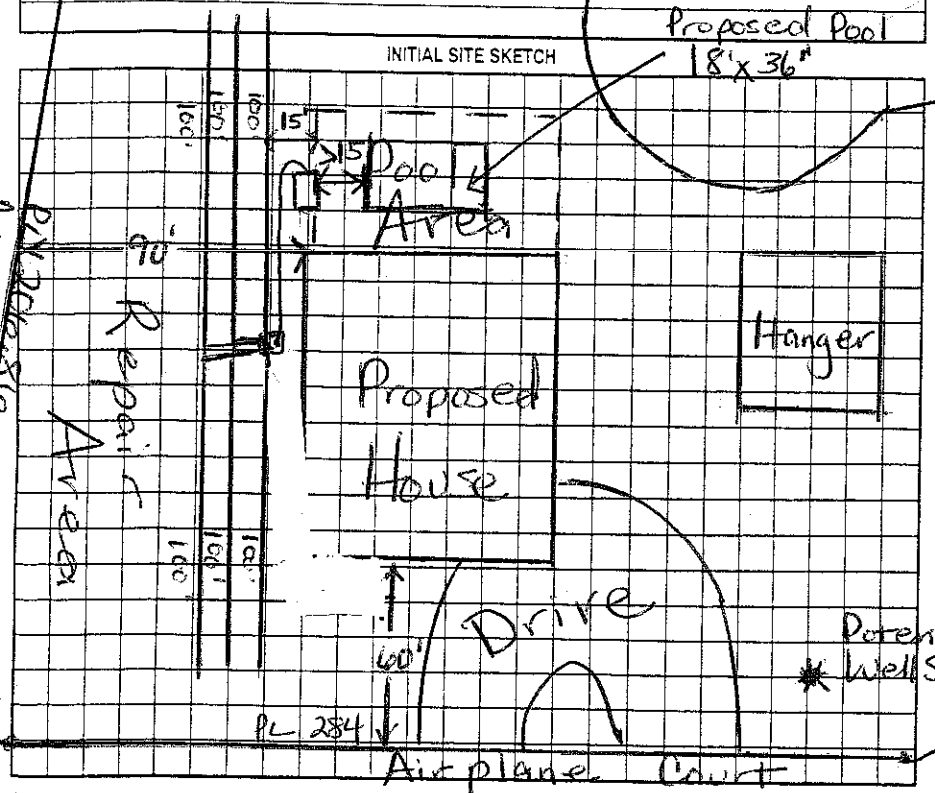

Comments/Conditions: Note: Must Keep Pool "cut" at least 15Ft from Septic System. ☆ Per Builder will not be cutting house site. 18'x36'

AS BUILT SKETCH

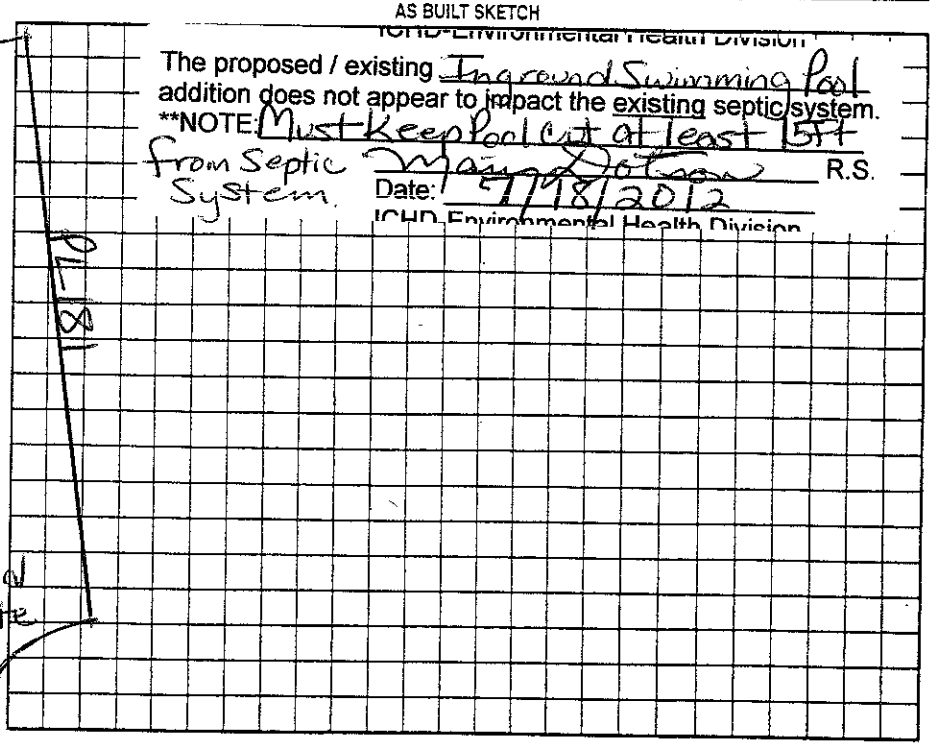

ICHD-Environmental Health Division

The proposed / existing Inground Swimming Pool addition does not appear to impact the existing septic system.

**NOTE: Must Keep Pool cut at least 15ft from Septic System.

Mary Dotson R.S.

Date: 7/18/2012

ICHD-Environmental Health Division

Permit can be suspended or revoked if any false information is supplied toward securing the permit/any unauthorized changes are made to the site/any unauthorized changes are made in the installation of the system. Improvement Permit with plat valid without expiration ☐ Improvement Permit with site plan valid for sixty months ☐ Authorization to Construct is valid for a period equal to that of Improvement Permit – not to exceed sixty months.

Signed: Matt Wimp date 5-7-07 Installed by: C+S Grading

Improvement Permit by: Mary Dotson RS date 5/7/07 Operation Permit by: Wesley Sparks R.S. date 1/24/08

Authorization to Construct by: Mary Dotson RS date 5/7/07 Existing System Inspection by: ____ date ____

HEALTH DEPT. COPY: WHITE OWNER COPY (FINAL): YELLOW OWNER COPY (INITIAL): PINK