IREDELL COUNTY HEALTH DEPARTMENT

STATESVILLE 704-878-5305 MOORESVILLE 704-664-5281

IMPROVEMENT PERMIT / CERTIFICATE OF COMPLETION / OPERATION PERMIT / EXISTING SYSTEM INSPECTION

PROPERTY DESCRIPTION NO. 17562 DATE 12/15/93 TAX MAP NO. 2P4 A 190 Watershed: ☐ Yes ☒ No

OWNER OR CONTRACTOR DANIEL McCAN ~~PHONE: Business~~ 463-53-1496 Home 846-5272

ADDRESS 301 AMANDA DR MATTHEWS, NC. 28105

LOCATION NORMANDY RD. TO 4th CULDESAC (NO NAME) TL TO (R) OF CULDESAC

SUBDIVISION LNAIRPARK BLOCK / SECTION ____ LOT 34 LOT AREA ~1.47 AC SITE CLASS. P DESIGN FLOW 480 L.T.A.R. .25-.3

Septic Tank: ~~1000~~ 1500 Gallons; STB 79 Date 11/22/94

Pump Tank: ____ Gallons; PT ____ Date ____

Pump Make: ____ Model ____ Serial No. ____

Nitrification Field: No Fields 1 Square Feet 1600 Linear Feet 533

No Lines 533 x 3' Trench Width 3' Max Trench Bottom Depth 36" Gravel Depth 12"

☒ New System ☐ Repair System Type: I, II, III, IV, V, VI

System Description: CONV - DROP BOX

Repair System Description: PANEL - DIST. BOX

Maintenance Agreement Required: ☐ Yes ☒ No

☒ House/Mod. Home No. Bedrooms 4

☐ Mobile Home No. Bathrooms 3

☐ Business No. Employees ____

☐ Other ____


☐ Slab ☒ Crawl Space ☐ Basement w/plumbing ☐ Basement wo/plumbing

Water Supply:
☒ Individual
☐ Community
☐ Public


Comments: Trench depth no greater than 36"

Comments: ② WELL

INITIAL SITE SKETCH

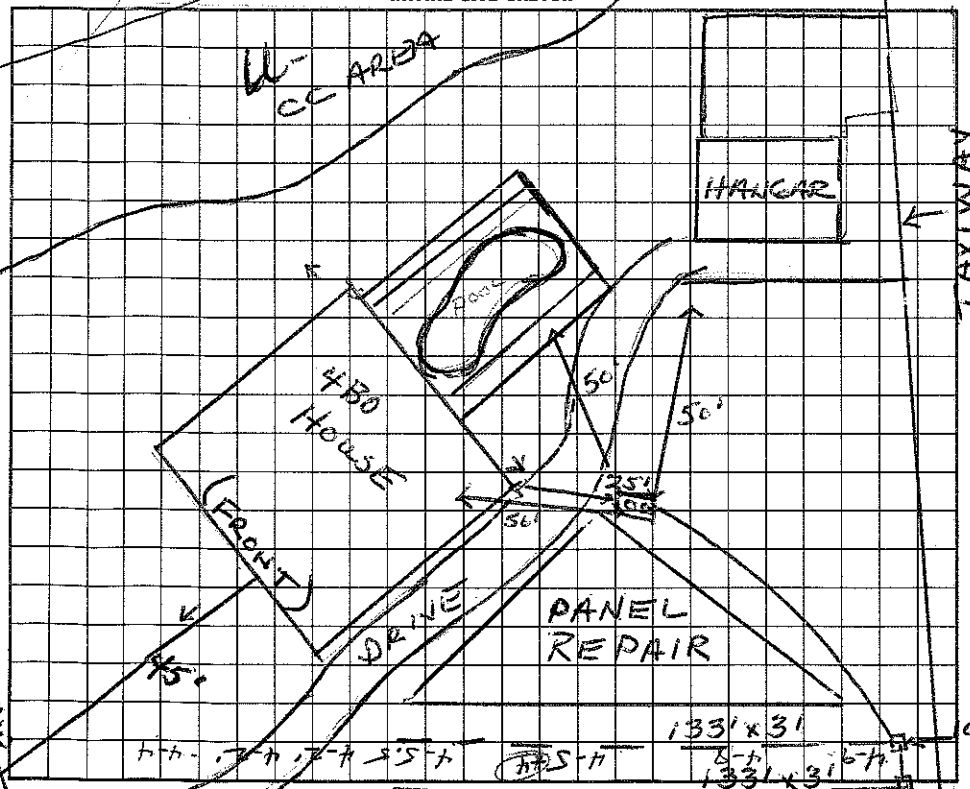

AS BUILT SKETCH

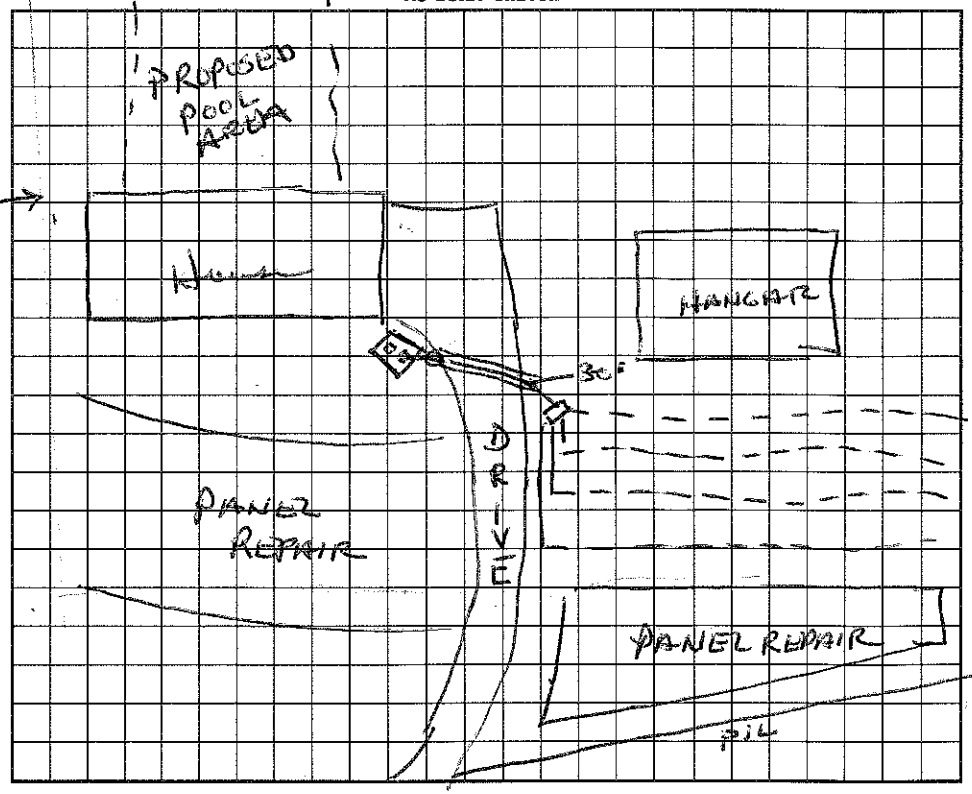

I understand that this permit can be suspended or revoked if any false information is supplied toward securing the permit/any unauthorized changes are made to the site/any unauthorized changes are made in the installation of the system. Improvement Permit is valid for 60 months from date of issuance.

Signed: MAILED AS REQUESTED 12/15/93

Improvement Permit by: Wesley Sparks date 12/15/93

Existing System Inspection by: ____ date ____

Installed by: Randy Aige

Certificate of Completion by: Wesley Sparks date 1/12/95

Operation Permit by: ____ date ____

HEALTH DEPT. COPY: WHITE INSPECTION COPY (FINAL): GREEN OWNER COPY (FINAL): YELLOW INSPECTION COPY (INITIAL): PINK OWNER COPY (INITIAL): GOLD