IREDELL COUNTY HEALTH DEPARTMENT - *ENVIRONMENTAL HEALTH* ☐ STATESVILLE OFFICE 704-878-5305 ☐ MOORESVILLE OFFICE 704-664-5281

IMPROVEMENT PERMIT / AUTHORIZATION TO CONSTRUCT / OPERATION PERMIT / EXISTING SYSTEM INSPECTION

PERMIT # 172282 PIN # 4638535012 DATE 6-6-2012

OWNER Thomas Delany APPLICANT: Charles Stevens PHONE: Home/Cell # 704660-5160 Business # 704622-9646

SITE ADDRESS 120 Airplane Ct M'ville, NC OWNER / APPLICANT ADDRESS 144 Pinnacle Ln M'ville, NC

SITE DIRECTIONS Hwy 150 W. TR Perth Rd TL Normandy TL Airplane Ct on right

SUBDIVISION Lk Norman Airpark BLOCK / SECTION LOT # 3 LOT AREA 1.784c DESIGN FLOW 480gpd L.T.A.R. .3

Septic Tank 1050 Gallons: STB 312 Date 5-19-12 ☒ New System ☐ Repair ☐ Expansion System Type I (II) III IV V VI Accepted

Pump Tank ____ Gallons: P T ____ Date ____ System Description: Gravity-25% Reduction

Pump Make ____ Model ____ Serial # ____ Repair System Description: Pump-25% Reduction

No. Nitrification Fields: 1 No. Lines 5 Linear Feet 400ft Maintenance Agreement Required ☐ YES ☒ NO

Trench Width 36" Max. Trench Bottom Depth 36" Gravel Depth N/A ☒ GRAVITY ☐ PRESSURE


☒ Residence No. Bedrooms 4 ☐ Business No. Persons ____ ☐ Other No. Employees ____ ☐ Slab ☒ Crawl Space ☐ Basement w/plumbing ☐ Basement w/o plumbing

Water Supply: ☒ Private ☐ Public ☐ Community


Comments / Conditions: Keep Septic System at least 10ft From PL. Install Drainlines on Contour Serial distribution Okay.

Edge of ST just below Crawl space door ~40ft off Hse. Installed 5 lines used Arc 36 (not certified)

INITIAL SITE SKETCH

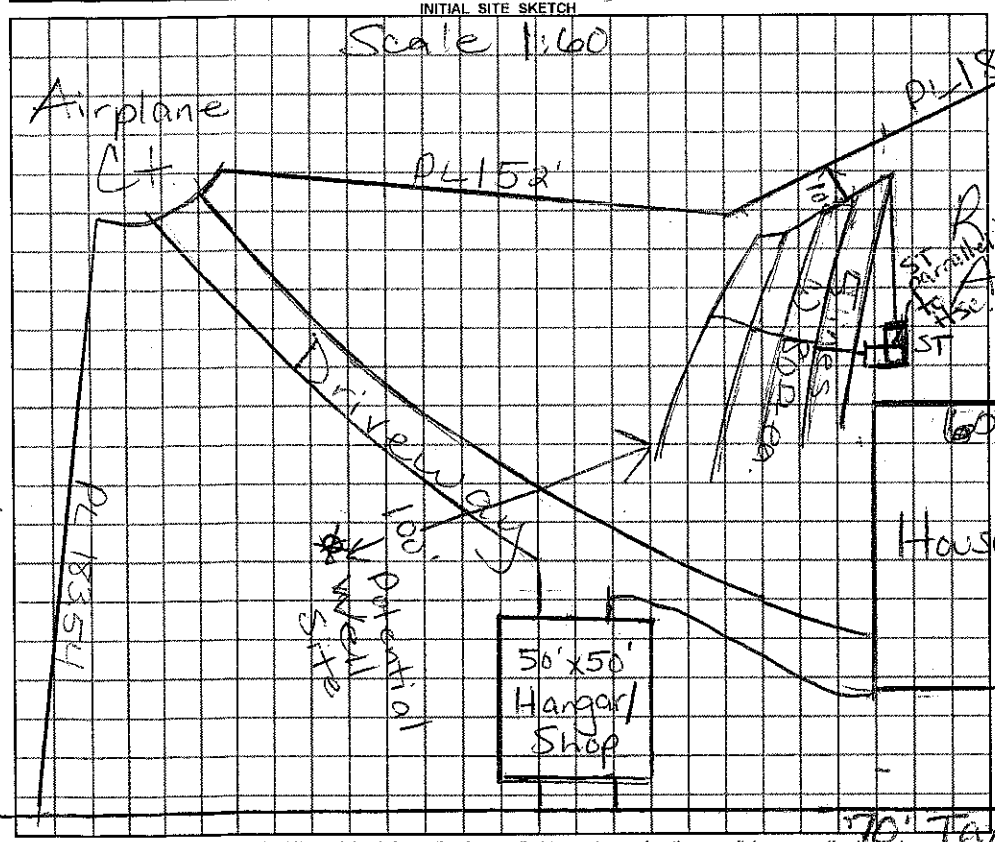

AS BUILT SKETCH

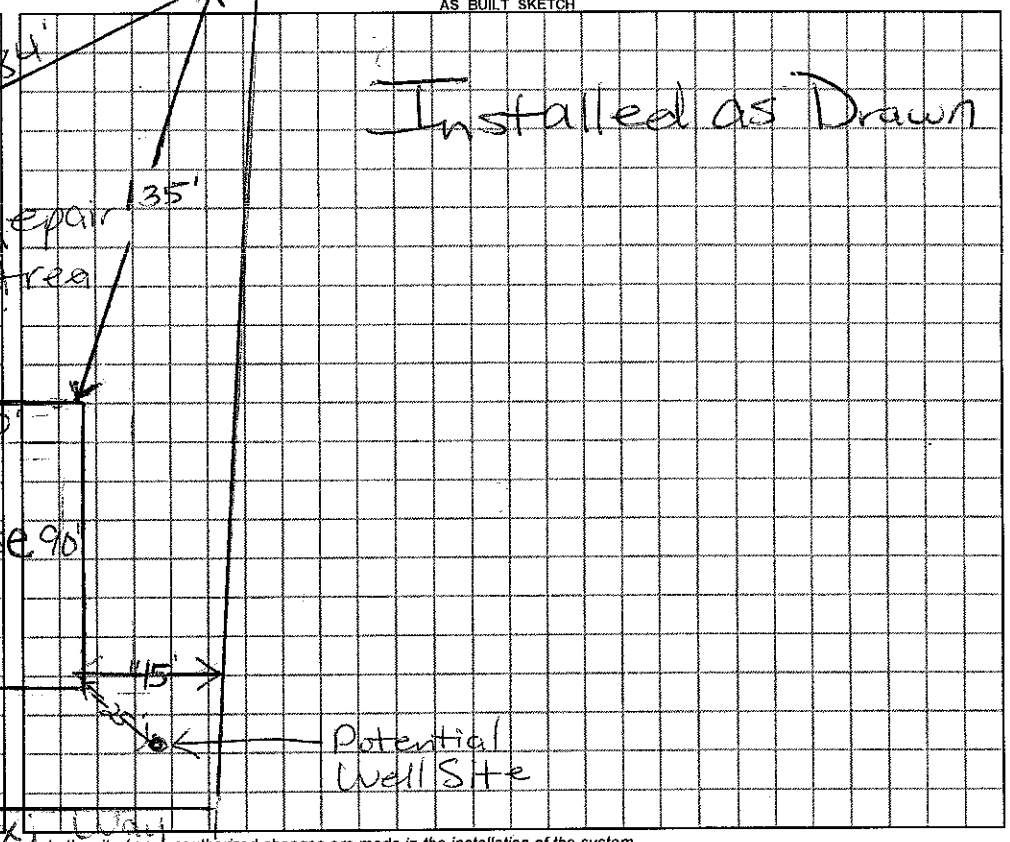

Permit can be suspended or revoked if any false information is supplied toward securing the permit / any unauthorized changes are made to the site / any unauthorized changes are made in the installation of the system.

☐ ***IMPROVEMENT PERMIT*** with plat valid without expiration. ☐ ***IMPROVEMENT PERMIT*** with ~~plat valid without expiration.~~ site plan valid 60 mo. ☐ ***AUTHORIZATION TO CONSTRUCT*** valid for period equal to IMPROVEMENT PERMIT--not to exceed 60 mo.

Applicant Signature: Charles Stevens Date 6/12/12 Installed by: Richard Abernathy

IMPROVEMENT PERMIT by: Marian Robertson REHS Date 6/6/12 OPERATION PERMIT by: Marian Robertson REHS Date 3/15/13

AUTHORIZATION TO CONSTRUCT by: Marian Robertson REHS Date 6/6/12 Existing System Inspected by: ____ REHS Date ____

811 CONTACT A LOCATOR SERVICE PRIOR TO ANY EXCAVATION

White Copy -- Environmental Health YELLOW COPY (Final) Owner / Applicant PINK COPY (Initial) Owner / Applicant