IREDELL COUNTY HEALTH DEPARTMENT

STATESVILLE 704-878-5305 MOORESVILLE 704-664-5281

IMPROVEMENT PERMIT / CERTIFICATE OF COMPLETION / OPERATION PERMIT / EXISTING SYSTEM INSPECTION

PROPERTY DESCRIPTION NO. 17966 DATE 6/30/95 TAX MAP NO. 2P A 14A Watershed: ☐ Yes ☒ No

OWNER OR CONTRACTOR ~~Thomas S Wilson~~ (Thomas B Kohler Jr) PHONE: Business 664-9737 ~~Home~~ 4638-53-7930

ADDRESS Rt 4 Box 11 Mooresville NC 28115

LOCATION Calvelain Rd. past office out gravel to lot on (E) at Hughston intersection

SUBDIVISION LN Airpark BLOCK / SECTION 5 LOT 52 LOT AREA 1.26 SITE CLASS. PS DESIGN FLOW 480 L.T.A.R. .93

Septic Tank: 1000 Gallons; STB 794 Date 8/16 Pump Tank: ___ Gallons; PT ___ Date ___

Pump Make: ___ Model ___ Serial No. ___

Nitrification Field: No Fields 1 Square Feet 1600 Lineal Feet ~~400~~ 450

No Lines 3 Trench Width 36" Max Trench Bottom Depth 36" Gravel Depth N/A

☒ New System ☐ Repair System Type: I, II, III, IV, V, VI

System Description: GRAVITY - INFILTRATOR

Repair System Description: SAME

Maintenance Agreement Required: ☐ Yes ☒ No

☒ House/Mod. Home No. Bedrooms 4

☐ Mobile Home No. Bathrooms 3

☐ Business No. Employees ___

☐ Other ___


☐ Slab ☒ Crawl Space ☐ Basement w/plumbing ☐ Basement wo/plumbing

Water Supply: ☒ Individual ☐ Community ☐ Public

Comments: + 25% reduction for Infiltrator use

Comments: installed as shown.

INITIAL SITE SKETCH

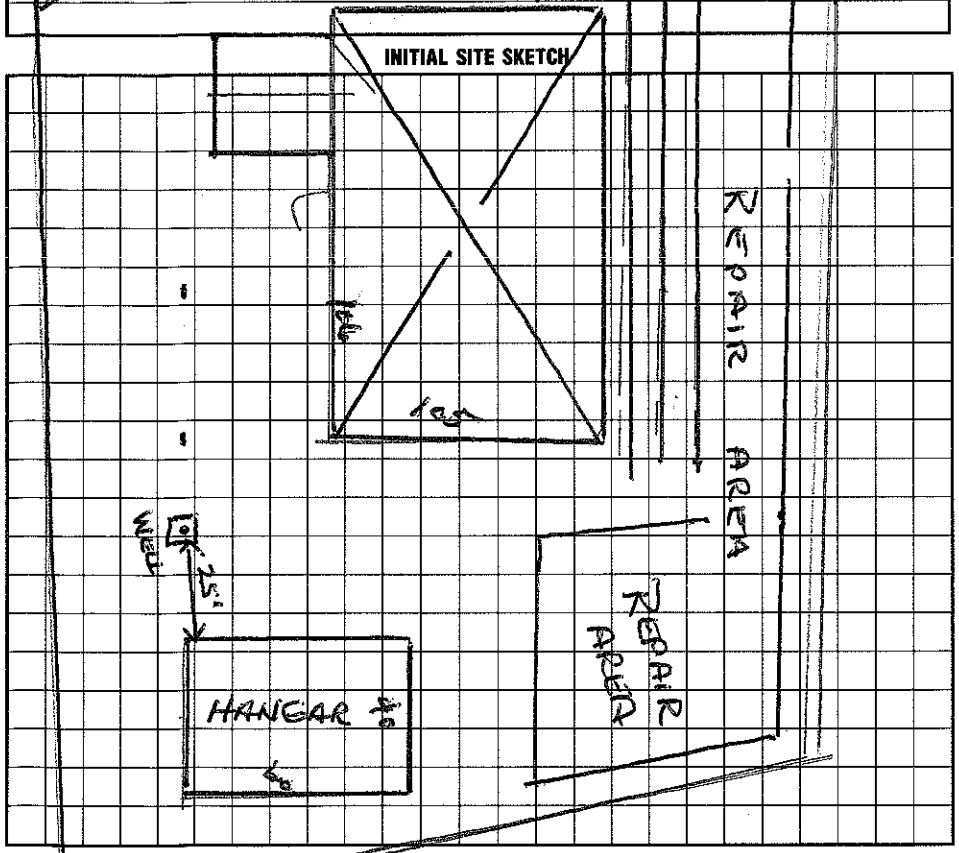

AS BUILT SKETCH

I understand that this permit can be suspended or revoked if any false information is supplied toward securing the permit/any unauthorized changes are made to the site/any unauthorized changes are made in the installation of the system. Improvement Permit is valid for 60 months from date of issuance.

Signed: Left at office JWS

Improvement Permit by: Wesley Sparks RS. date 6/30/95

Existing System Inspection by: ___ date ___

Installed by: Randy Lipe

Certificate of Completion by: ___ date ___

Operation Permit by: Wesley Sparks RS. date 9/20/96

HEALTH DEPT. COPY: WHITE INSPECTION COPY (FINAL): GREEN OWNER COPY (FINAL): YELLOW INSPECTION COPY (INITIAL): PINK OWNER COPY (INITIAL): GOLD