HEALTH DEPARTMENT

MOORESVILLE 704-664-5281

PERMIT / CERTIFICATE OF COMPLETION / OPERATION PERMIT / EXISTING SYSTEM INSPECTION

APPLICATION NO. 18833 DATE 10/6/94 TAX MAP NO. 2P 4A 168 Watershed: ☐ Yes ☒ No

OWNER OR CONTRACTOR Donald Douthitt PHONE-Business 4638-54-2702 Home

ADDRESS 21300 Blakeney Shores Dr. Davidson NC. 28036

LOCATION Normandy Rd. Lot on (L) before Lindbergh Ln.

SUBDIVISION LN Airpark BLOCK / SECTION LOT 14 LOT AREA ~ 1.67 AC SITE CLASS. P DESIGN FLOW ~~330~~ 360 AWS L.T.A.R. x 3

Septic Tank: 1000 Gallons; STB 794 Date 1/17/95

Pump Tank: Gallons; PT Date

Pump Make: Model Serial No. 300 feet

Nitrification Field: No Fields 1 Square Feet 1200 Linear Feet ~~440~~

No Lines 4 Trench Width 36" Max Trench Bottom Depth 30" Gravel Depth 12"

☒ New System ☐ Repair System Type: I, II, III, IV, V, VI

System Description: DIST BOX - CONVENTIONAL

Repair System Description:

Maintenance Agreement Required: ☐ Yes ☐ No

☒ House/Mod. Home No. Bedrooms ~~4~~ X

☐ Mobile Home No. Bathrooms 2

☐ Business No. Employees

☐ Other


☐ Slab ☒ Crawl Space ☐ Basement w/plumbing ☐ Basement wo/plumbing

Water Supply: ☒ Individual ☐ Community ☐ Public


Comments: Sleeve in 6" DOT STD CULVERT MATERIAL
MAX TRENCH DEPTH 30" - FOLLOW CONTOURS
9/15/95 changed to ~~Perk~~ AWS

Comments: 9/19/ Maybe 4 feet of Infiltrator AWS
9/20/95 - 360 Homes may use 360 FT INFILTRATOR AWS

INITIAL SITE SKETCH

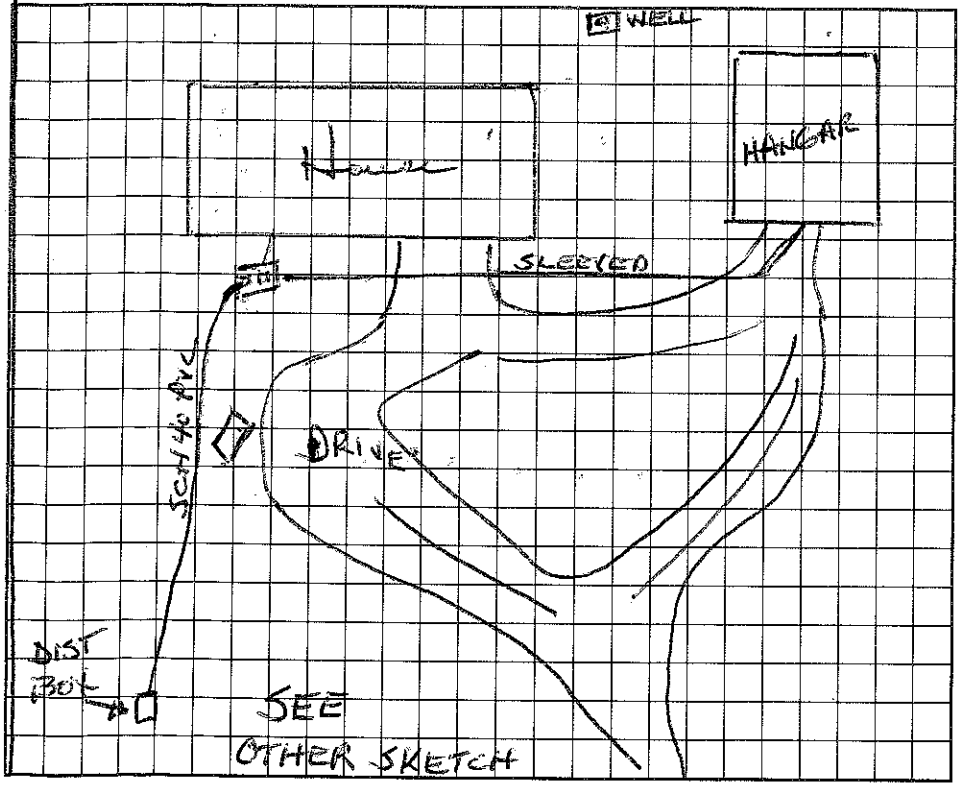

~~AS BUILT~~ INITIAL SKETCH FOR DRAINFIELD

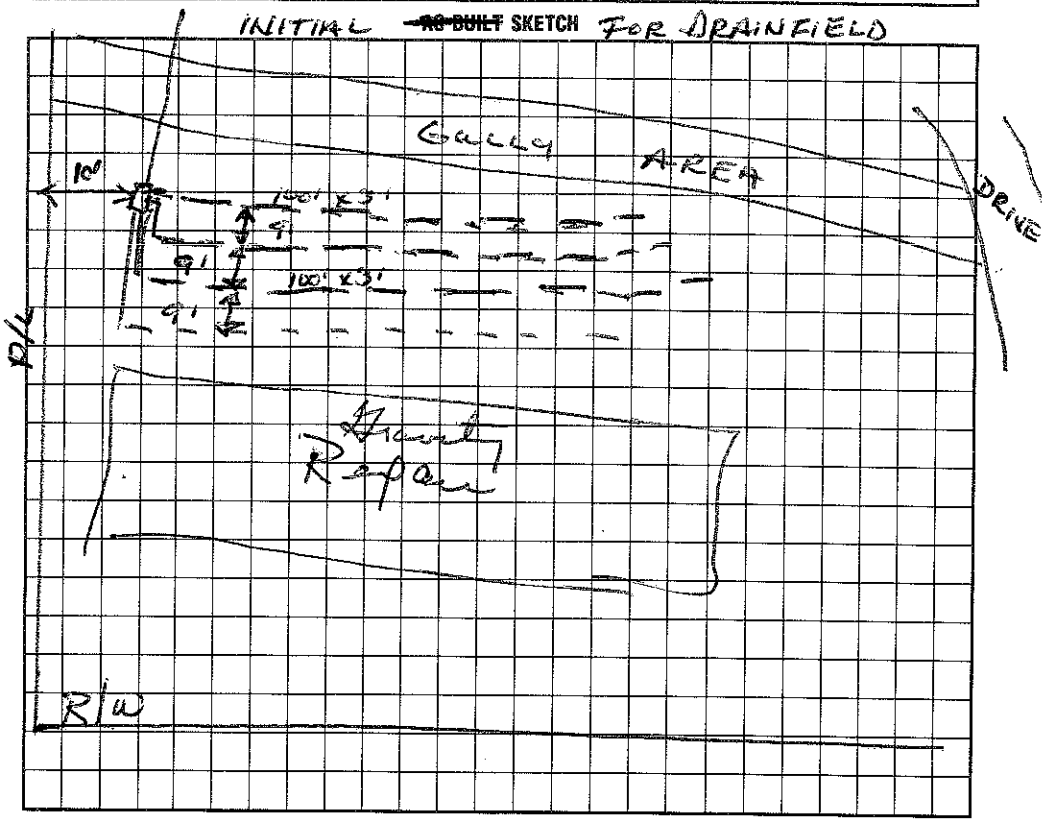

I understand that this permit can be suspended or revoked if any false information is supplied toward securing the permit/any unauthorized changes are made to the site/any unauthorized changes are made in the installation of the system. Improvement Permit is valid for 60 months from date of issuance.

Signed: [signature]

Improvement Permit by: Wesley Sparks R.S. date 10/6/94

Existing System Inspection by: date

Installed by: Richard Abernathy

Certificate of Completion by: Wesley Sparks R.S. date 9/27/95

Operation Permit by: date

HEALTH DEPT. COPY: WHITE INSPECTION COPY (FINAL): GREEN OWNER COPY (FINAL): YELLOW INSPECTION COPY (INITIAL): PINK OWNER COPY (INITIAL): GOLD