IREDELL COUNTY HEALTH DEPARTMENT

STATESVILLE 704-878-5305 MOORESVILLE 704-664-5281

IMPROVEMENT PERMIT / CERTIFICATE OF COMPLETION / OPERATION PERMIT / EXISTING SYSTEM INSPECTION

PROPERTY DESCRIPTION NO. 19323 DATE 8/2/95 TAX MAP NO. 2P-4-14-169 Watershed: ☐ Yes ☒ No

OWNER OR CONTRACTOR Brian Build PHONE: Business 4638-54-2919 Home

ADDRESS 184 Pennicillin Pt. Troutman NC

LOCATION CORNER OF NORMANDY RD + LINDBERGH LN ON (L) CORNER

SUBDIVISION LNAIRPARK BLOCK / SECTION LOT 16 LOT AREA ~1.10ac SITE CLASS. P DESIGN FLOW 360 L.T.A.R. .3

Septic Tank: 1000 Gallons; STB 794 Date 6/26/95

Pump Tank: Gallons; PT Date

Pump Make: Model Serial No.

Nitrification Field; No Fields 1 Square Feet 1200 Linear Feet 400

No Lines 4 Trench Width 36" Max Trench Bottom Depth 36" Gravel Depth 12"

☒ New System ☐ Repair System Type: I, II, III, IV, V, VI

System Description:

Repair System Description:

Maintenance Agreement Required: ☐ Yes ☐ No

☒ House/Mod. Home No. Bedrooms 3

☐ Mobile Home No. Bathrooms 2

☐ Business No. Employees

☐ Other


☐ Slab ☒ Crawl Space ☐ Basement w/plumbing ☐ Basement wo/plumbing

Water Supply: ☒ Individual ☐ Community ☐ Public

Comments: 8/23/95 - OK'd use of Repair for Original System - System once here now becomes Repair Area Also May use 300 ft. of INFILTRATOR IN REPAIR AREA.

Comments: As-built as drawn on sh. P.

INITIAL SITE SKETCH

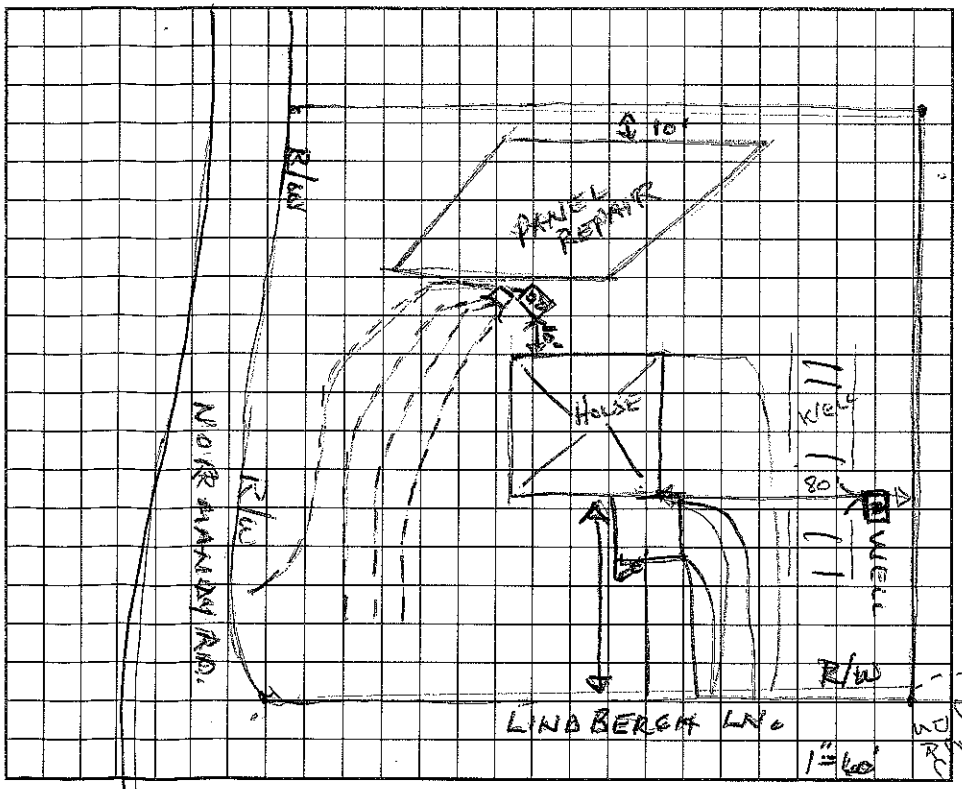

AS BUILT SKETCH

I understand that this permit can be suspended or revoked if any false information is supplied toward securing the permit/any unauthorized changes are made to the site/any unauthorized changes are made in the installation of the system. Improvement Permit is valid for 60 months from date of issuance.

Signed:

Improvement Permit by: Wesley Sparks RS. date

Existing System Inspection by: date

Installed by: F J Ennis

Certificate of Completion by: Wesley Sparks RS date 9/8/95

Operation Permit by: date

HEALTH DEPT. COPY: WHITE INSPECTION COPY (FINAL): GREEN OWNER COPY (FINAL): YELLOW INSPECTION COPY (INITIAL): PINK OWNER COPY (INITIAL): GOLD