IREDELL COUNTY HEALTH DEPARTMENT

STATESVILLE 704-878-5305 MOORESVILLE 704-664-5281

IMPROVEMENT PERMIT / CERTIFICATE OF COMPLETION / OPERATION PERMIT / EXISTING SYSTEM INSPECTION

PROPERTY DESCRIPTION NO. 15984 DATE 6/21/93 4638544323 TAX MAP NO. 2P-4-A-165

OWNER OR CONTRACTOR H+H CONTRACTORS (KOENING) PHONE: Business 892-9106 Home

ADDRESS Outside Lp LAKE NORMAN AIRPARK

LOCATION NORMANOY RD, TL Outside Lp to Cuide SAC ON(R)

SUBDIVISION LINAIR PARK BLOCK / SECTION LOT 11 LOT AREA SITE CLASS. P L.T.A.R. .25-.3

Water Supply: ☑ Individual ☐ Community ☐ Public

Septic Tank: 1500 Gallons; STB 780 Date 4/25/93

Pump Tank: 1500 Gallons; PT 691 Date 4/25/93

Nitrification Field: No Fields 1 Square Feet 1200 Linear Feet 400

No Lines 5 Trench Width 3 Trench Depth 36 Gravel Depth 12"

☑ New System ☐ Repair System Type: I, II, (III), IV, V, VI

System Description: CONV - Pump

Repair System Description: CONV - Pump

Maintenance Agreement Required: ☐ Yes ☐ No

☑ House/Mod. Home No. Bedrooms 3 Garbage Disposal: ☑ Yes ☐ No

☐ Mobile Home No. Bathrooms 2.5 Auto. Dishwasher: ☑ Yes ☐ No

☐ Business No. Employees Auto. Washing Machine: ☑ Yes ☐ No

☐ Other ☑ Other JACCUZI


☐ Slab ☑ Crawl Space ☐ Basement w/plumbing ☐ Basement wo/plumbing

Comments REPAIR SYSTEM - PRESSURE PANELS

RUNWAY

INITIAL SITE SKETCH

AS BUILT SKETCH

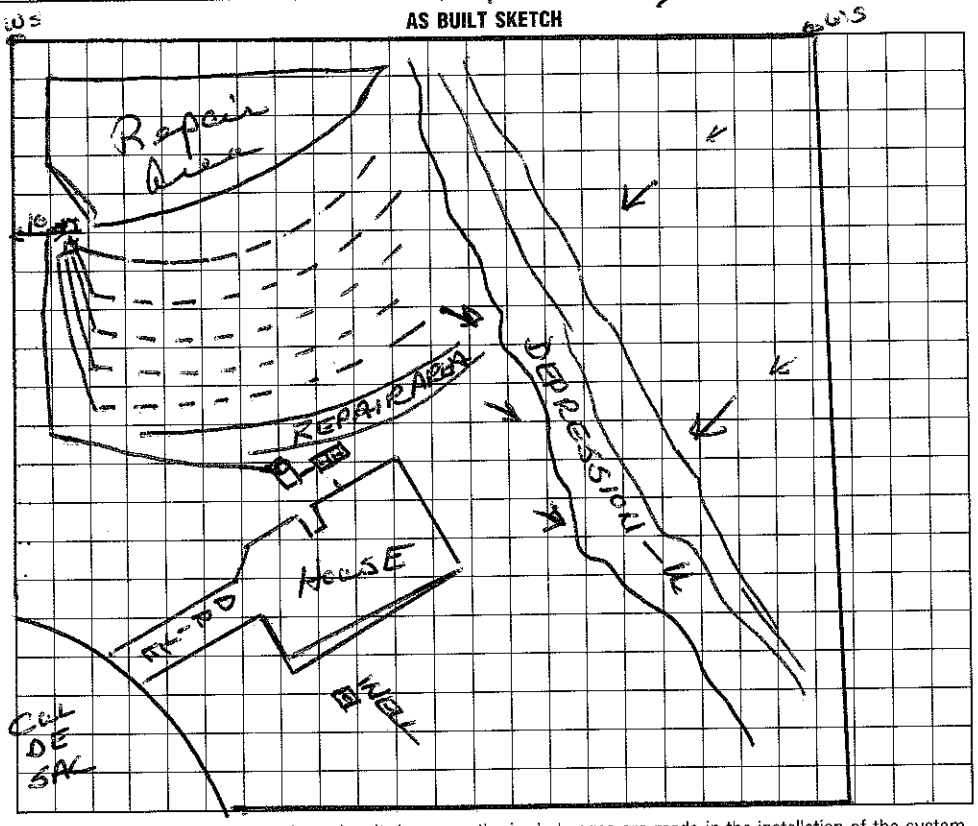

I understand that this permit can be suspended or revoked if any false information is supplied toward securing the permit/any unauthorized changes are made to the site/any unauthorized changes are made in the installation of the system. Improvement Permit is valid for 60 months from date of issuance.

Signed:

Improvement Permit by: date

Existing System Inspection by: date

Installed by: FT ERVIN

Certificate of Completion by: Wesley Sparks RS. date 6/22/93

Operation Permit by: date

HEALTH DEPT. COPY: WHITE INSPECTION COPY (FINAL): GREEN OWNER COPY (FINAL): YELLOW INSPECTION COPY (INITIAL): PINK OWNER COPY (INITIAL): GOLD