IREDELL COUNTY HEALTH DEPARTMENT

STATESVILLE 704-878-5305 MOORESVILLE 704-664-5281

IMPROVEMENT PERMIT / CERTIFICATE OF COMPLETION / OPERATION PERMIT / EXISTING SYSTEM INSPECTION

PROPERTY DESCRIPTION NO. 17844 DATE 2/22/94 TAX MAP NO. 2P-4A 164 Watershed: ☑ Yes ☐ No

OWNER OR CONTRACTOR JE SCHNICKER PHONE: Business 664-9491 Home 664-9491

ADDRESS R+4 Box 16 MOORESVILLE NC. 28115 4638-54-5187

LOCATION OUTSIDE LOOP, NORMANDY RD TL OUTSIDE Loop, ON (L) side of cul de sac

SUBDIVISION LN AIRPARK BLOCK / SECTION 1 LOT 10 LOT AREA ~1.21AC SITE CLASS. P DESIGN FLOW 360 L.T.A.R. .2-.25

Septic Tank: 1000 Gallons; STB 794 Date 12/9/94

Pump Tank: ____ Gallons; PT ____ Date ____

Pump Make: ____ Model ____ Serial No. ____

Nitrification Field: No Fields 1 Square Feet 1440 Linear Feet * 240

No Lines 3 Trench Width 2' Max Trench Bottom Depth 36" Gravel Depth 6" SAND

☑ New System ☐ Repair System Type: I, II, (III) IV, V, VI

System Description: PREFAB PANELS 16"

Repair System Description: SAME

Maintenance Agreement Required: ☑ Yes ☐ No 1 YR

☑ House/Mod. Home ☐ Mobile Home ☐ Business ☐ Other

No. Bedrooms 3 No. Bathrooms 3 No. Employees ____


☑ Slab ☐ Crawl Space ☑ Basement w/plumbing ☐ Basement wo/plumbing

Water Supply: ☑ Individual ☐ Community ☐ Public

Comments: * .5 REDUCTION FOR PANEL USE
REAR HALF OF HOUSE HAS BASEMENT UNDER IT
ALSO

Comments:

INITIAL SITE SKETCH

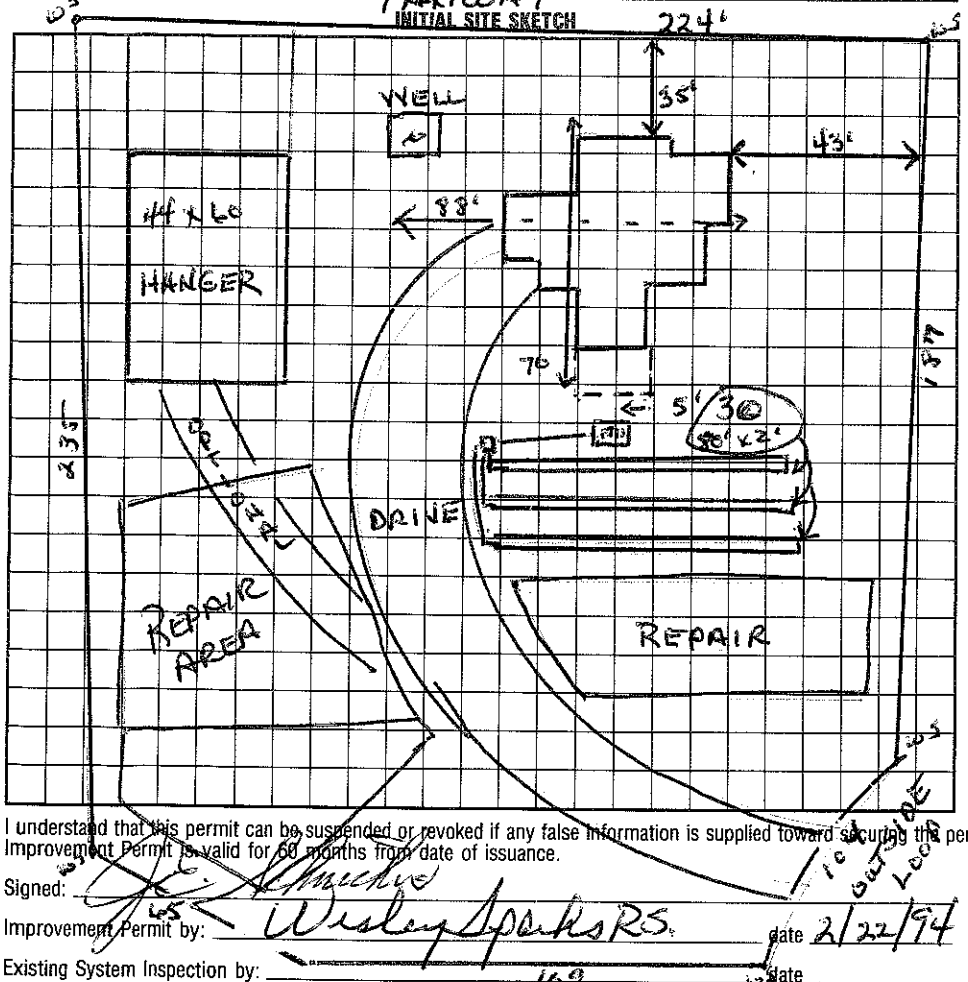

AS BUILT SKETCH

I understand that this permit can be suspended or revoked if any false information is supplied toward securing the permit/any unauthorized changes are made to the site/any unauthorized changes are made in the installation of the system. Improvement Permit is valid for 60 months from date of issuance.

Signed: J.E. Schnicker

Improvement Permit by: Wesley Sparks RS. date 2/22/94

Existing System Inspection by: ____ date ____

Installed by: Larry Beam

Certificate of Completion by: Wesley Sparks RS. date 1/23/95

Operation Permit by: ____ date ____

HEALTH DEPT. COPY: WHITE INSPECTION COPY (FINAL): GREEN OWNER COPY (FINAL): YELLOW INSPECTION COPY (INITIAL): PINK OWNER COPY (INITIAL): GOLD