IREDELL COUNTY HEALTH DEPARTMENT

STATESVILLE 704-878-5305 130.00 Paid MOORESVILLE 704-664-5281

IMPROVEMENT PERMIT / AUTHORIZATION TO CONSTRUCT / OPERATION PERMIT / EXISTING SYSTEM INSPECTION

PERMIT# 107958 PIN# 4638 54 7480 DATE 8/16/02

OWNER OR CONTRACTOR Mark Mayerchak PHONE: Business 336-575-9695 Home

ADDRESS 756 Southwest Dr. Davidson, NC. 28036

LOCATION Perth N TL Normandy Rd, TL Outside Loop. L corner lot.

SUBDIVISION LNAP BLOCK / SECTION LOT 55(9) LOT AREA 166 1.6AC SITE CLASS. PS DESIGN FLOW 480 L.T.A.R. .3

Septic Tank: 1000 Gallons; STB 1000 Date 4/26/02

Pump Tank: Gallons; PT Date

Pump Make: Model Serial No.

Nitrification Field: No Fields 1 Square Feet 800 Linear Feet 267

No Lines 4@67 Trench Width 2-3' Max Trench Bottom Depth 36" Gravel Depth SAND

☒ New System ☐ Repair System Type: I, II, (III) IV, V, VI

System Description: GRAV - 16"PPBPS

Repair System Description: PRESSURE - 50% Reduced

Maintenance Agreement Required: ☐ Yes ☒ No

☒ House/Mod. Home ☐ Mobile Home ☐ Business ☐ Other

No. Bedrooms 4 No. Bathrooms 4 No. Employees

☐ Slab ☐ Crawl Space ☒ Basement w/plumbing ☐ Basement wo/plumbing


Water Supply: ☒ Individual ☐ Public ☐ Community

Comments:/Conditions: HANGAR


Comments:/Conditions:

(1"=40')

INITIAL SITE SKETCH

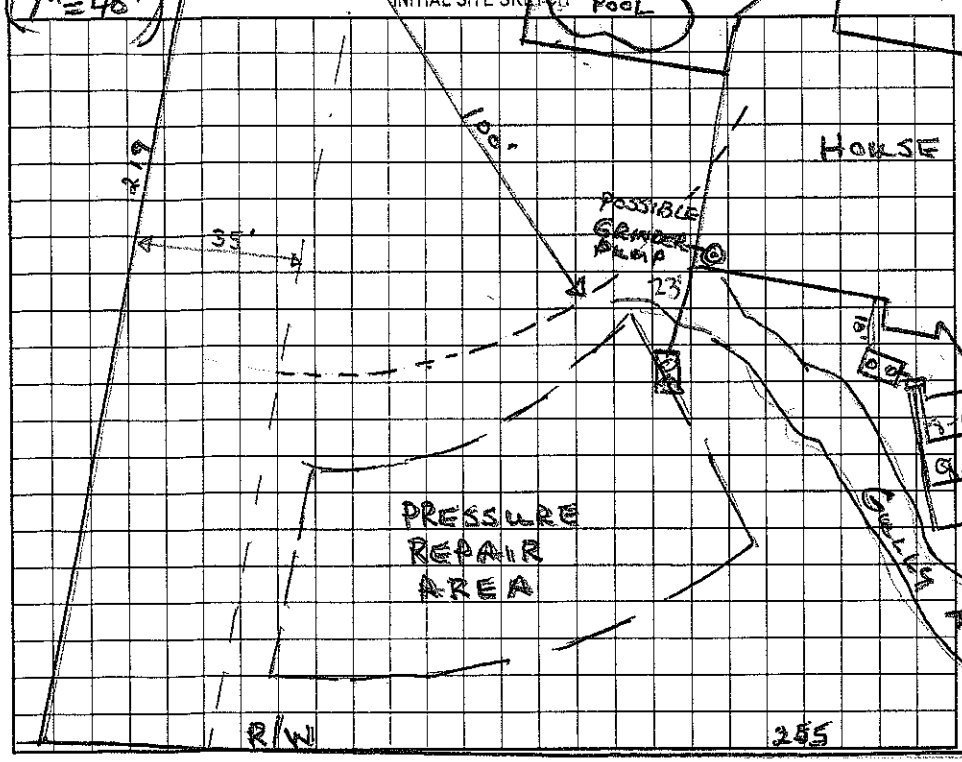

AS BUILT SKETCH

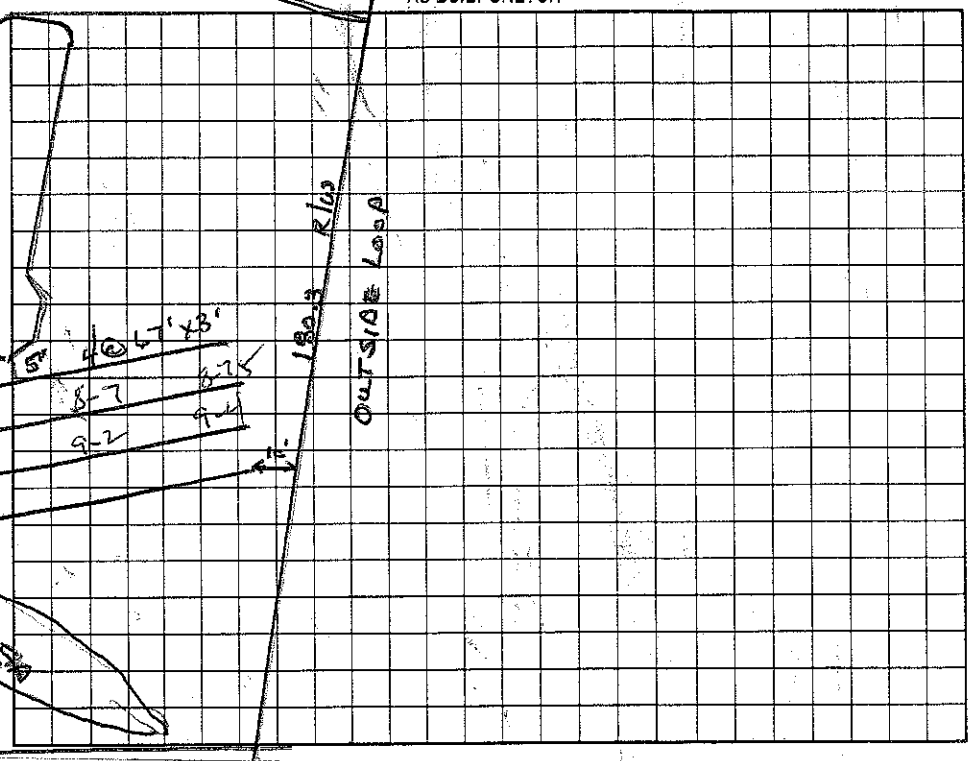

Permit can be suspended or revoked if any false information is supplied toward securing the permit/any unauthorized changes are made to the site/any unauthorized changes are made in the installation of the system. Improvement Permit with plat valid without expiration. Improvement Permit with site plan valid for sixty months. Authorization to Construct is valid for a period equal to that of Improvement Permit – not to exceed sixty months.

Signed: Mark Mayerchak date 9-23-02 NORMANDY RD. Installed by: Wayne County

Improvement Permit by: Wesley Sparks RS. date 8/16/02 Operation Permit by: Wesley Sparks RS. date 6/7/03

Authorization to Construct by: Wesley Sparks RS date 8/16/02 Existing System Inspection by: date

HEALTH DEPT. COPY: WHITE OWNER COPY (FINAL): YELLOW OWNER COPY (INITIAL): PINK