LAKE NORMAN AIRPARK

IREDELL COUNTY HEALTH DEPARTMENT

STATES – 704-878-5305 50.00 Paid MOORESVILLE 704-664-5281

IMPROVEMENT PERMIT / AUTHORIZATION TO CONSTRUCT / OPERATION PERMIT / EXISTING SYSTEM INSPECTION

PERMIT# 118249 PIN# 4638 55 0169 DATE 2/16/04

OWNER OR CONTRACTOR Keith Whitehead PHONE: Business 704-660-5847 Home

ADDRESS 122 Tanager Rd. Mooresville, NC 28117

LOCATION Perth N to Normandy Rd. to Lindbergh Ln. on (R) Corner

SUBDIVISION LN Airpark BLOCK / SECTION LOT 18 LOT AREA 1.24 ac SITE CLASS. PS DESIGN FLOW 480 L.T.A.R. .3

Septic Tank: 1000 Gallons; STB 794 Date 10/6/04
Pump Tank: 1000 Gallons; PT 283 Date 10/5/04
Pump Make: Ecoflo Model Ecoflo 7PNC Serial No. E0451558
Nitrification Field: No Fields 1 Square Feet 534/801 Linear Feet 267
No Lines 4@67' Trench Width 2-3' Max Trench Bottom Depth 3' Gravel Depth N/A

[X] New System [ ] Repair System Type: I, II, III, (IV), V, VI
System Description: Pres Dosed - 16" PPBPS
Repair System Description: PPBPS
Maintenance Agreement Required: [X] Yes [ ] No


[X] House/Mod. Home No. Bedrooms 4
[ ] Mobile Home No. Bathrooms 3
[ ] Business No. Employees
[ ] Other
[ ] Slab [ ] Crawl Space [X] Basement w/plumbing [ ] Basement wo/plumbing

Water Supply: [X] Individual [ ] Public [ ] Community

Comments:/Conditions:

Comments:/Conditions:

INITIAL SITE SKETCH

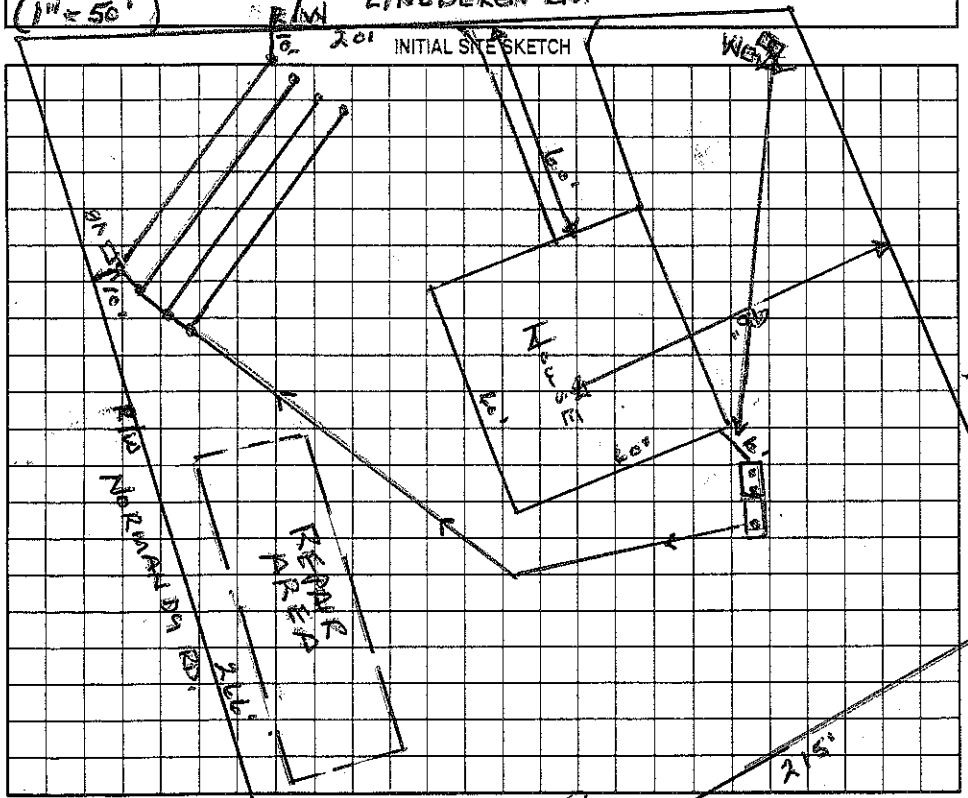

AS BUILT SKETCH

Permit can be suspended or revoked if any false information is supplied toward securing the permit/any unauthorized changes are made to the site/any unauthorized changes are made in the installation of the system. Improvement Permit with plat valid without expiration. Improvement Permit with site plan valid for sixty months. Authorization to Construct is valid for a period equal to that of Improvement Permit – not to exceed sixty months.

Signed: * date 2/18/04 Installed by: Osborne & Sons

Improvement Permit by: Wesley Sparks RS. date 2/16/04 Operation Permit by: Wesley Sparks RS date 12/1/04

Authorization to Construct by: Wesley Sparks RS date 2/16/04 Existing System Inspection by: date

HEALTH DEPT. COPY: WHITE OWNER COPY (FINAL): YELLOW OWNER COPY (INITIAL): PINK