IREDELL COUNTY HEALTH DEPARTMENT

STATESVILLE 704-878-5305 MOORESVILLE 704-664-5281

IMPROVEMENT PERMIT / AUTHORIZATION TO CONSTRUCT / OPERATION PERMIT / EXISTING SYSTEM INSPECTION

PERMIT# 21378 / 81944 PID# 2P 4A 79 4638-55-4245 DATE 6/7/99

OWNER OR CONTRACTOR William Kutner PHONE: Business Home 664-7640

ADDRESS 719 S Magnolia St. Mooresville, NC. 28115

LOCATION 150 W TR Perth Rd. TL Normandy Rd. TR across from Lindbergh Lane

SUBDIVISION CL+T BLOCK / SECTION 11 LOT 79 LOT AREA .75 AC SITE CLASS. RS DESIGN FLOW 480 L.T.A.R. .3

Septic Tank: 1000 Gallons; STB 312 Date 11/10/99

Pump Tank: 1000 Gallons; PT 27 Date 8/27/99

Pump Make: ZOELLER Model E-1L5C Serial No. 8/30/99

Nitrification Field: No Fields 1 Square Feet 800 Linear Feet 240

No Lines 6@45'&3 Trench Width 36" Max Trench Bottom Depth 36" Gravel Depth SAND

[X] New System [ ] Repair System Type: I, II, III, (IV), V, VI

System Description: Pressure to 16" PPBS

Repair System Description: Same

Maintenance Agreement Required: [X] Yes [ ] No

[X] House/Mod. Home No. Bedrooms 4

[ ] Mobile Home No. Bathrooms 5

[ ] Business No. Employees

[ ] Other


[ ] Slab [ ] Crawl Space [X] Basement w/plumbing [ ] Basement wo/plumbing

Water Supply: [X] Individual [ ] Public [ ] Community


Comments/Conditions: WELL #1 MUST BE PROPERLY ABANDONED; WELL #2 TO BE LOCATED AS SHOWN HERE;

Comments/Conditions: 36, 43, 45, 52, 52, 40

INITIAL SITE SKETCH

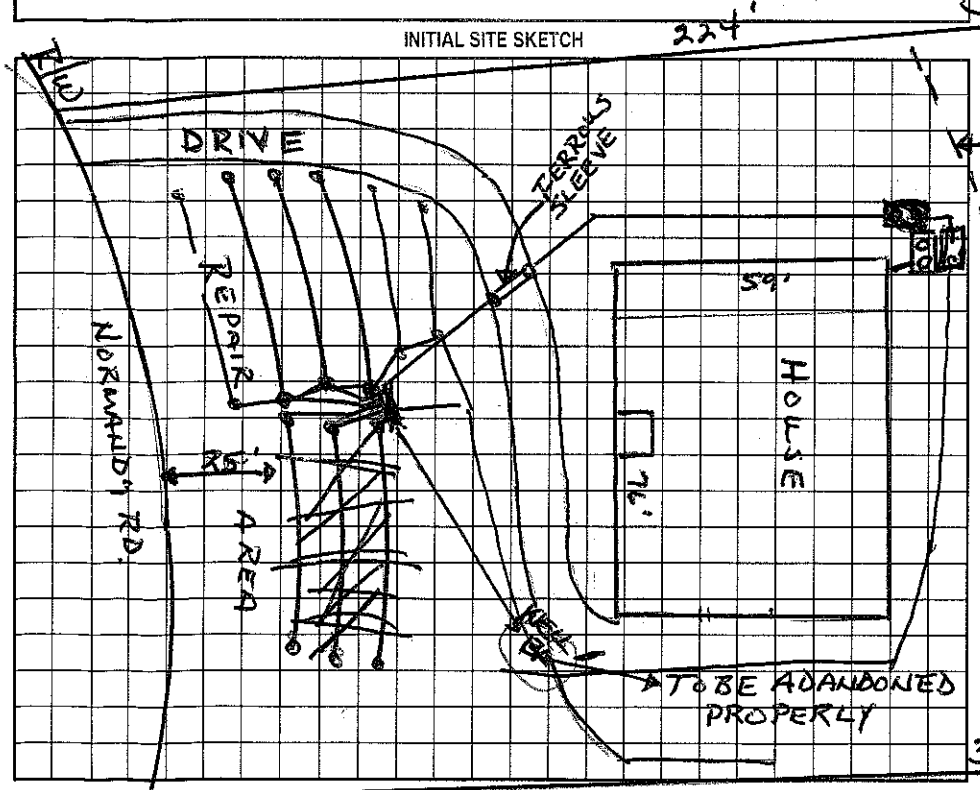

AS BUILT SKETCH

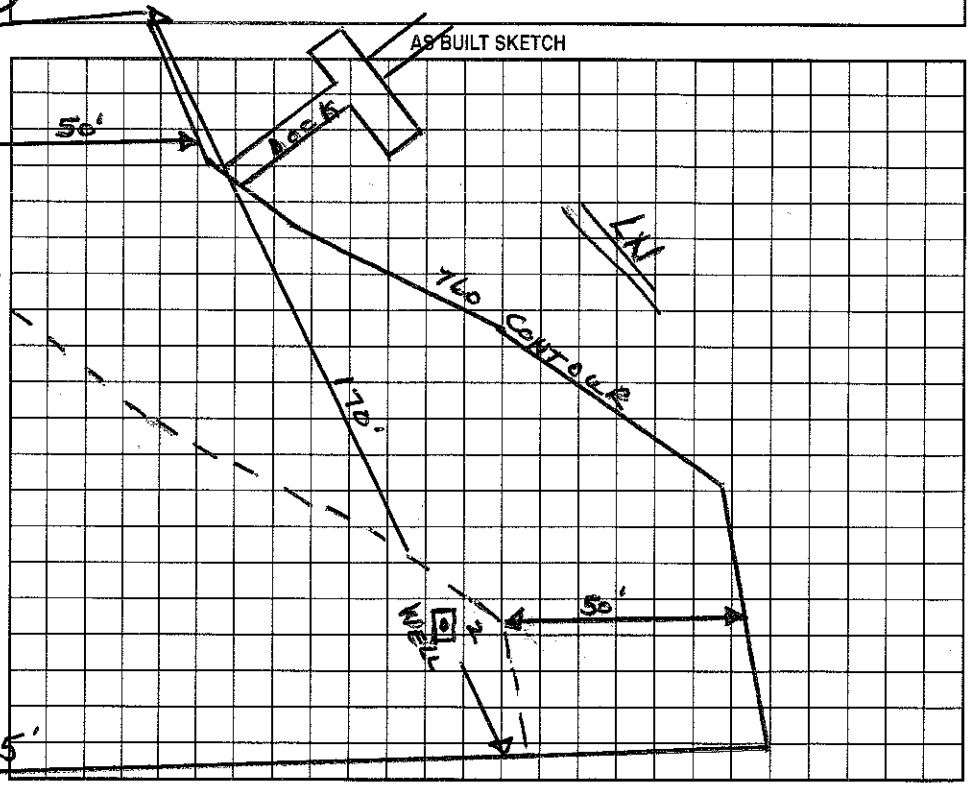

Permit can be suspended or revoked if any false information is supplied toward securing the permit/any unauthorized changes are made to the site/any unauthorized changes are made in the installation of the system. Improvement Permit with plat valid without expiration. Improvement Permit with site plan valid for sixty months. Authorization to Construct is valid for a period equal to that of Improvement Permit – not to exceed sixty months.

Signed: * Phillip Caudill date 6/8/99 Installed by: Larry Bogan

Improvement Permit by: Wesley Sparks RS. date 6/7/99 Operation Permit by: Wesley Sparks RS. date 4/17/00

Authorization to Construct by: Wesley Sparks RS. date 6/7/99 Existing System Inspection by: date

HEALTH DEPT. COPY: WHITE OWNER COPY (FINAL): YELLOW OWNER COPY (INITIAL): PINK