IREDELL COUNTY HEALTH DEPARTMENT

STATESVILLE 704-878-5305 50.00 T & A MOORESVILLE 704-664-5281

IMPROVEMENT PERMIT / AUTHORIZATION TO CONSTRUCT / OPERATION PERMIT / EXISTING SYSTEM INSPECTION

DATE 11/13/03

PERMIT# 110202 PIN# 4638 56 2905 PHONE: Business Home 704-875-2933

OWNER OR CONTRACTOR Richard J. Brzezinski

ADDRESS 8928 Deerland Ct. Huntersville NC. 28078

LOCATION Perth Rd Tl Stumpy Creek Tl Collingwood TR Folkstone on (L) # 163

SUBDIVISION C L + T BLOCK / SECTION 14 LOT 79 LOT AREA SITE CLASS. PS DESIGN FLOW 480 L.T.A.R. .3

Septic Tank: 1000 Gallons; STB 312 Date 11/6/04

Pump Tank: 1000 Gallons; PT 283 Date "

Pump Make: ZOELLER Model Serial No.

Nitrification Field: No Fields 1 Square Feet 534/501 Linear Feet 267

No Lines 5@53' Trench Width 2 - 3' Max Trench Bottom Depth 3' Gravel Depth N/A

[X] New System [ ] Repair System Type: I, II, (III) IV, V, VI

System Description: GRAVITY - 16" PPBBS

Repair System Description: < 1983 RECORDED

Maintenance Agreement Required: [ ] Yes [ ] No

[ ] House/Mod. Home No. Bedrooms 4

[ ] Mobile Home No. Bathrooms 3.5

[ ] Business No. Employees

[ ] Other


[ ] Slab [ ] Crawl Space [ ] Basement w/plumbing [ ] Basement wo/plumbing

Water Supply: [X] Individual [ ] Public [ ] Community


Comments:/Conditions: 2' ON 8' CNTRS / 3' ON 9' CNTRS.
Property Line between 79 + 80 must revert back to original C L + T plat configuration / Well abandonment form must be received before OP will be issued.

Comments:/Conditions:
Well 1 must be properly abandoned and well 2 drilled in location shown.

INITIAL SITE SKETCH (1" = 50')

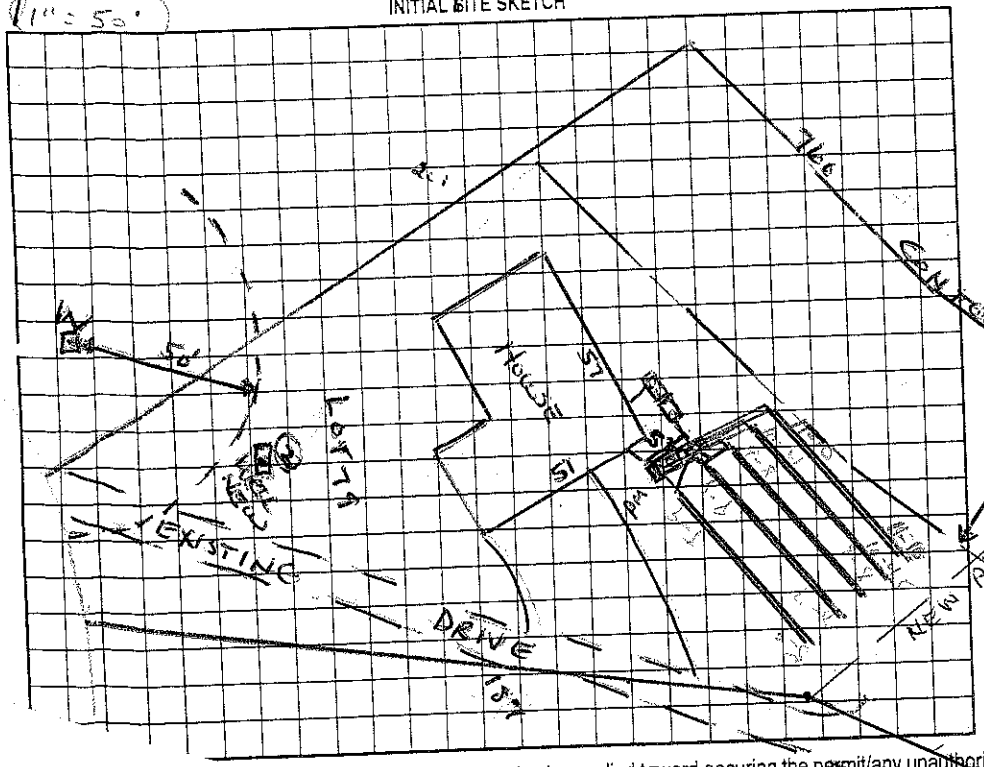

AS BUILT SKETCH

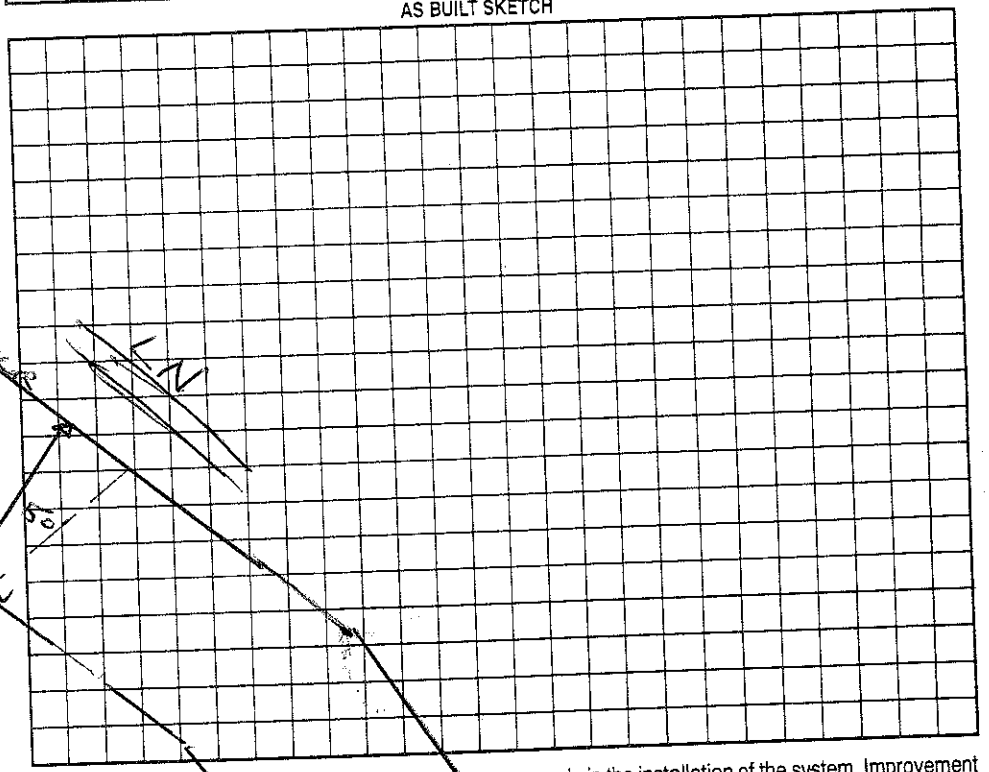

Revoked if any false information is supplied toward securing the permit/any unauthorized changes are made to the site/any unauthorized changes are made in the installation of the system. Improvement Permit Expiration: Improvement Permit with site plan valid for sixty months. Authorization to Construct is valid for a period equal to that of Improvement Permit – not to exceed sixty months.

by: [signature] date 11/18/03

Wesley Sparks RS. date 11/14/03

Wesley Sparks RS. date 11/14/03

Installed by: C R Rousseau

Operation Permit by: Wesley Sparks RS. date 6/17/04

Existing System Inspection by: date

HEALTH DEPT. COPY: WHITE OWNER COPY (FINAL): YELLOW OWNER COPY (INITIAL): PINK