IREDELL COUNTY HEALTH DEPARTMENT

(SEPTIC TANK) IMPROVEMENTS PERMIT AND CERTIFICATE OF COMPLETION
(Ground Absorption Sewage Disposal System – G. S. Chapter 130-Article 13C)

OWNER OR CONTRACTOR Daniel C. Boone DATE 11-24-76 PERMIT NO. _____

PHONE: Business _____ Home 545-3337

LOCATION 1303 N TL on 1400 1st Rd TL ½ mi on right S. R. No. _____

SUBDIVISION NAME Lake Norman LOT NO. 71 SECTION OR BLOCK NO. 14


House ( ) Mobile Home (✓) Business ( ) Other _____

No. Bedrooms 3 No. Bathrooms 1

Garbage Disposal Unit	Yes	( )	No	(✓)
Auto. Dishwasher	Yes	(✓)	No	( )
Auto. Wash. Machine	Yes	(✓)	No	( )
Site Suitable	Yes	(✓)	No	( )

Lot Area 3/4 acre

Character & Porosity of Soil Clay loam Porosity Fair
Percolation Rate Soil borings
Topography 6% Slope
Depth to Water Table 10'+
Rock or other impervious formations none in area of system

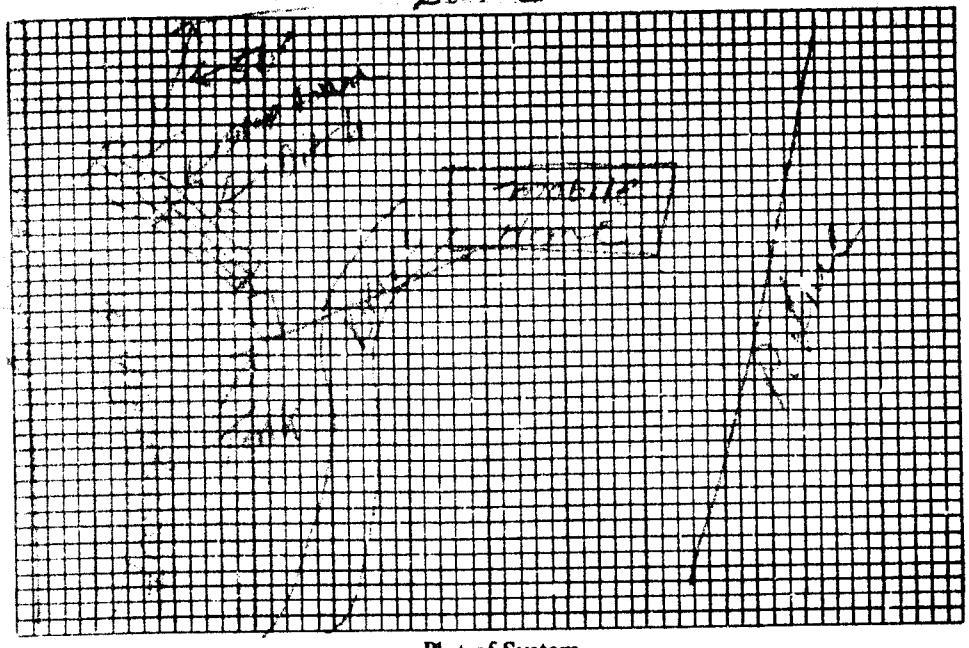

Plot of System

Size of Tank 1000 Gals.
Nitrification Field:
No. of Lines 4
Sq. Ft. 625 Linear Ft. 250
Depth of Stone in Lines 10"
Water Supply: Individual (✓)
Public ( )

Installed by E. J. Ervin

IMPROVEMENTS PERMIT BY J. C. Moore

COMMENTS: area had Tremendous amount of bedrock where it was laid out so changed to left side but had to run lines takeing Slope. Therefore it was deep & used Step down.

CERTIFICATE OF COMPLETION BY J. C. Moore DATE 11-24-76

CONSTRUCTION MUST COMPLY WITH ALL OTHER APPLICABLE STATE AND LOCAL REGULATIONS.

Health Dept. Copy: White Inspection Dept. Copy: Yellow Sanitarian's Copy: Pink Owner's Copy: Gold