IREDELL COUNTY HEALTH DEPARTMENT

STATESVILLE 704-878-5305 125.00 Paid 11:30 MOORESVILLE 704-664-5281

IMPROVEMENT PERMIT / AUTHORIZATION TO CONSTRUCT / OPERATION PERMIT / EXISTING SYSTEM INSPECTION

PERMIT# 102,971 (03750) PIN# 4638566616 Steve Pelchat DATE 10-30-2001

OWNER OR CONTRACTOR Richard & Theresa Feile PHONE: Business 363-4846 Home

ADDRESS #1 Kettle Knoll Path Miller Place NY 11764

LOCATION Perth Rd to Stumpy Creek TL Collingswood ~ 1/2 mile on right + #206

SUBDIVISION BLOCK / SECTION LOT LOT AREA SITE CLASS. PS DESIGN FLOW 360gpd L.S.A.R.

Septic Tank: 1000 Gallons; STB 825 Date 8/30/01
Pump Tank: Gallons; PT Date
Pump Make: Model Serial No.
Nitrification Field: No Fields 1 Square Feet 450' Linear Feet 150'
No Lines 2075 Trench Width 36" Max Trench Bottom Depth 36" Gravel Depth 12"

X New System ☐ Repair System Type: I, II, III, IV, V, VI
System Description: Gravity Conventional
Repair System Description: Decreased prior to 1953
Maintenance Agreement Required: ☐ Yes ☐ No


X House/Mod. Home ☐ Mobile Home ☐ Business ☐ Other
No. Bedrooms 3/3 No. Bathrooms No. Employees
☐ Slab ☐ Crawl Space X Basement w/plumbing ☐ Basement wo/plumbing

Water Supply: X Individual ☐ Public ☐ Community

Comments/Conditions: Install new Septic tank due to existing one being damaged. Install 2-75' Conv lines & "Drop box" to Existing System

Comments/Conditions: Upgrade From 2 Bedrooms to 3 Bedrooms. (Add to Drainfield & replace Septic Tank.)

INITIAL SITE SKETCH

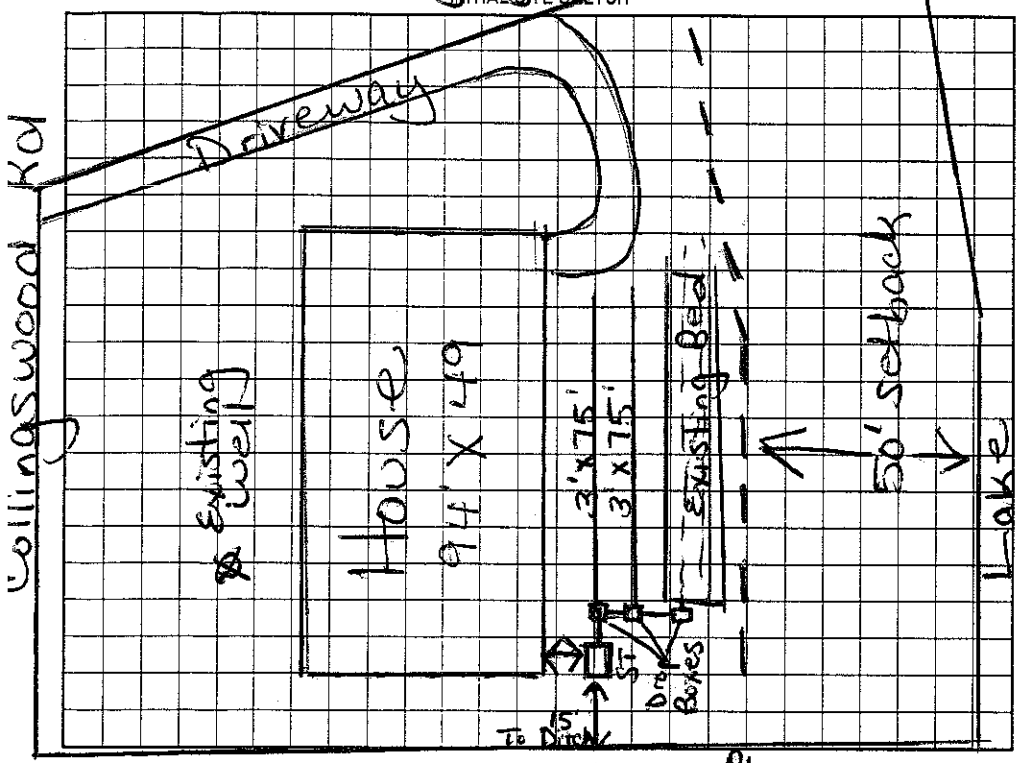

AS BUILT SKETCH

Permit can be suspended or revoked if any false information is supplied toward securing the permit/any unauthorized changes are made to the site/any unauthorized changes are made in the installation of the system. Improvement Permit with plat valid without expiration. Improvement Permit with site plan valid for sixty months. Authorization to Construct is valid for a period equal to that of Improvement Permit – not to exceed sixty months.

Signed: RS date 10-31-01 Installed by: Statesville Backhoe

Improvement Permit by: Maria H. Dolson RS date 10/30/01 Operation Permit by: RSI date 11/8/01

Authorization to Construct by: Maria H. Dolson RS date 10/30/01 Existing System Inspection by: date

HEALTH DEPT. COPY: WHITE OWNER COPY (FINAL): YELLOW OWNER COPY (INITIAL): PINK