IREDELL COUNTY HEALTH DEPARTMENT

STATESVILLE 704-878-5305 MOORESVILLE 704-664-5281

IMPROVEMENT PERMIT / AUTHORIZATION TO CONSTRUCT / OPERATION PERMIT / EXISTING SYSTEM INSPECTION

PERMIT# 120693 PIN# 4638-57-1414 DATE 6/14/04

OWNER OR CONTRACTOR Robert Camino PHONE: Business _____ Home (203) 375-4229

ADDRESS 50 Curtis Ave. Stratford CT 06615

LOCATION Perth, TL Stumpy Crk, TL Collingswood, TR Folkstone, on LT

SUBDIVISION _____ BLOCK / SECTION _____ LOT 7 LOT AREA 1.54 ac SITE CLASS. FS DESIGN FLOW 450 L.T.A.R. 0.5

Septic Tank: 1000 Gallons: STB 1007 Date 7/1/04

Pump Tank: _____ Gallons: PT _____ Date _____

Pump Make: _____ Model _____ Serial No. _____

Nitrification Field: No Fields 1 Square Feet 1600 Linear Feet 533'

No Lines 5@107' Trench Width 36" Max Trench Bottom Depth 36" Gravel Depth 12"

☐ New System ☐ Repair System Type: I, II, III, IV, V, VI

System Description: Gravity Conventional

Repair System Description: Pump Evaluative

Maintenance Agreement Required: ☐ Yes ☒ No

☒ House/Mod. Home No. Bedrooms 4

☐ Mobile Home No. Bathrooms 2.5

☐ Business No. Employees ____

☐ Other _____

☐ Slab ☒ Crawl Space ☐ Basement w/plumbing ☐ Basement wo/plumbing


Water Supply: ☒ Individual ☐ Public ☐ Community

Comments:/Conditions:


1"=60'

Comments:/Conditions:

INITIAL SITE SKETCH

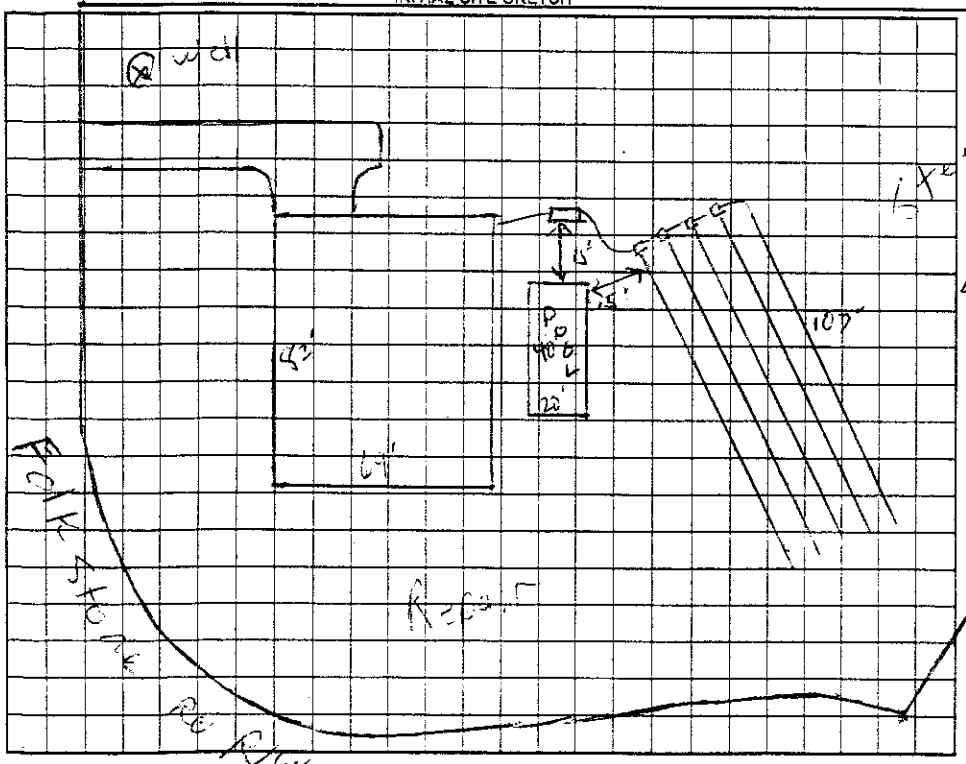

AS BUILT SKETCH

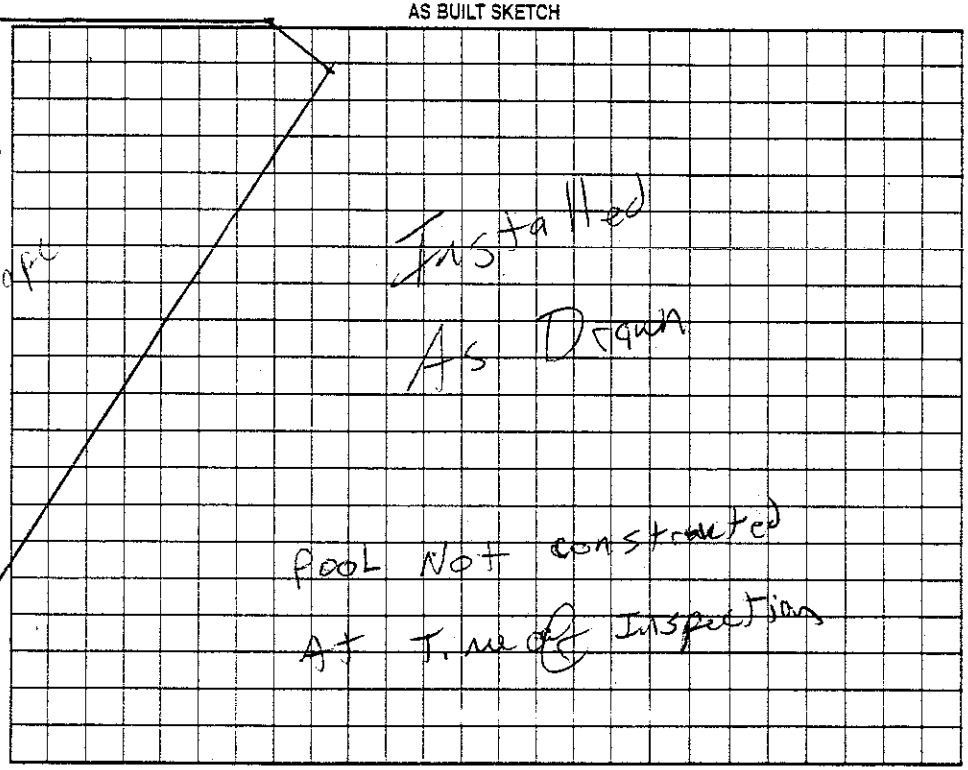

Permit can be suspended or revoked if any false information is supplied toward securing the permit/any unauthorized changes are made to the site/any unauthorized changes are made in the installation of the system. Improvement Permit with plat valid without expiration. Improvement Permit with site plan valid for sixty months. Authorization to Construct is valid for a period equal to that of Improvement Permit – not to exceed sixty months.

Signed: RCC Chad. date 6/16/04 Installed by: Sammy Shoemaker

Improvement Permit by: _____ RS date 6/14/04 Operation Permit by: _____ RS date 8/23/04

Authorization to Construct by: _____ RS date 6/14/04 Existing System Inspection by: _____ date _____

HEALTH DEPT. COPY: WHITE OWNER COPY (FINAL): YELLOW OWNER COPY (INITIAL): PINK