IREDELL COUNTY HEALTH DEPARTMENT

STATESVILLE 704-878-5305 MOORESVILLE 704-664-5281

IMPROVEMENT PERMIT / AUTHORIZATION TO CONSTRUCT / OPERATION PERMIT / EXISTING SYSTEM INSPECTION

PERMIT# 12664470 PIN# 4638571419 DATE 2-4-05

OWNER OR CONTRACTOR Sun Fun Pool Company/Robert Cimino PHONE: Business 873-2321 Home

ADDRESS 117 E. Broad St Statesville, NC 28677

LOCATION Perth Rd TL Stumpy Creek TL Collingswood TR Folk Stone on left

SUBDIVISION Haustman BLOCK / SECTION LOT 1 LOT AREA 1.54 Acre SITE CLASS PS DESIGN FLOW 480 L.T.A.R. .3

Septic Tank: 1000 Gallons; STB Date

Pump Tank: Gallons; PT Date

Pump Make: Model Serial No. –

Nitrification Field: No Fields 1 Square Feet 1600 Linear Feet 533

No Lines 5@107 Trench Width 36" Max Trench Bottom Depth 36 Gravel Depth 12

☐ New System ☐ Repair System Type: I, II, III, IV, V, VI (I)

System Description: Existing Gravity-Convent

Repair System Description: Pump Innovative

Maintenance Agreement Required: ☐ Yes ☒ No

☒ House/Mod. Home No. Bedrooms 4

☐ Mobile Home No. Bathrooms 2.5

☐ Business No. Employees

☐ Other


☐ Slab ☒ Crawl Space ☐ Basement w/plumbing ☐ Basement wo/plumbing

Water Supply: ☒ Individual ☐ Public ☐ Community


Comments:/Conditions: Existing Septic System appears to be Functioning OKay at time of inspection Scale 1:60

Comments:/Conditions: Swimming pool meets required setback of 15FT or greater to Septic System

INITIAL SITE SKETCH

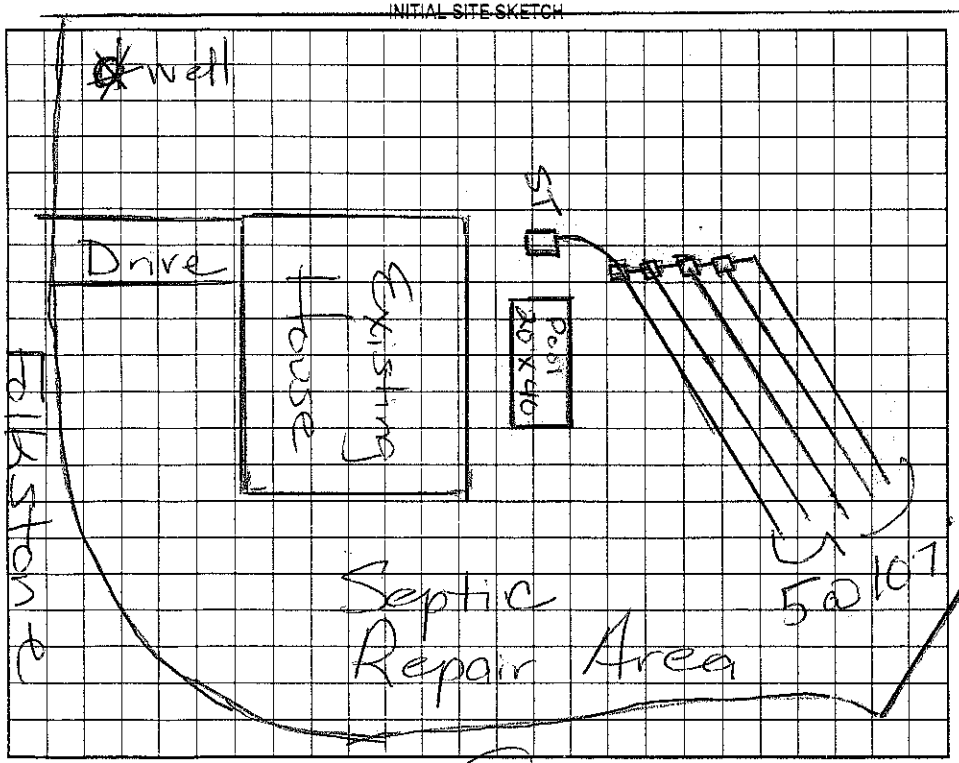

AS BUILT SKETCH

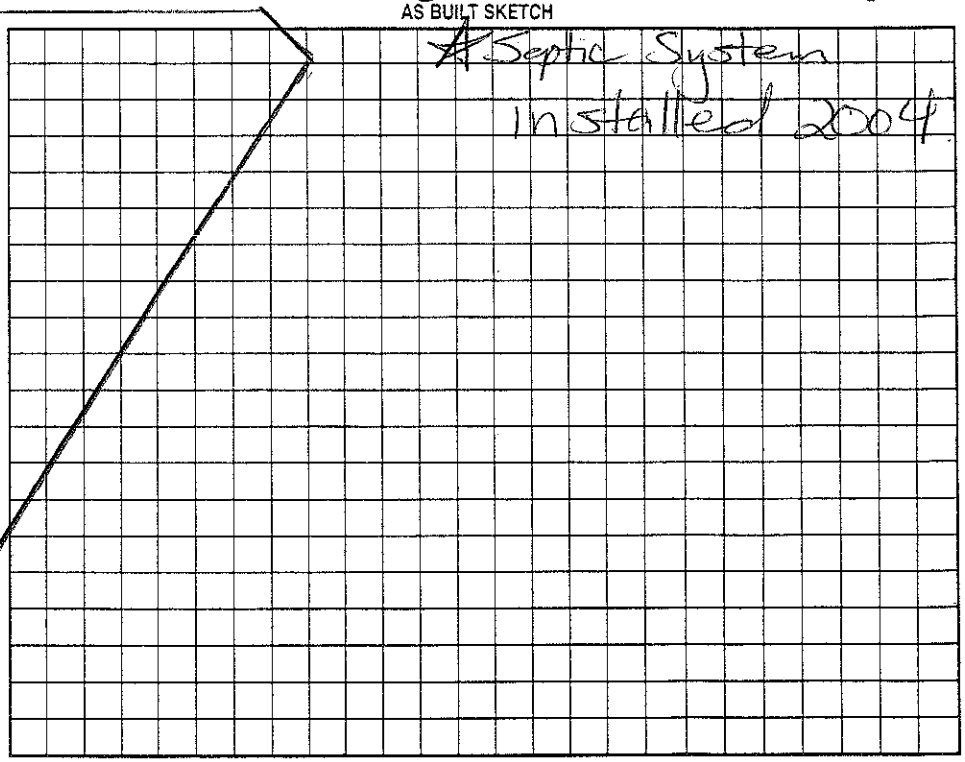

Permit can be suspended or revoked if any false information is supplied toward securing the permit/any unauthorized changes are made to the site/any unauthorized changes are made in the installation of the system. Improvement Permit with plat valid without expiration. Improvement Permit with site plan valid for sixty months. Authorization to Construct is valid for a period equal to that of Improvement Permit – not to exceed sixty months.

Signed: Robert W. Cimino date Installed by:

Improvement Permit by: date Operation Permit by:

Authorization to Construct by: Maintained Dotson RS date 2/4/05 Existing System Inspection by: Maintained Dotson RS date 2/4/05

HEALTH DEPT. COPY: WHITE OWNER COPY (FINAL): YELLOW OWNER COPY (INITIAL): PINK