IREDELL COUNTY HEALTH DEPARTMENT

STATESVILLE 704-878-5305 50.00 Paid MOORESVILLE 704-664-5281

IMPROVEMENT PERMIT / AUTHORIZATION TO CONSTRUCT / OPERATION PERMIT / EXISTING SYSTEM INSPECTION

PERMIT# 73970 PIN# 4638 57 5218 4638-57-5209 DATE 8/30/01

OWNER OR CONTRACTOR Barry Auman PHONE: Business _____ Home 704-799-0768

ADDRESS 470 Stuff Rd Mooresville NC 28117

LOCATION Perth, TL Stumpy Cok, TL Collings Wood, on RT

SUBDIVISION Hartman BLOCK / SECTION _____ LOT 4 LOT AREA 1.57 Ac SITE CLASS. PS DESIGN FLOW 480 L.T.A.R. 0.3

Septic Tank: 1000 Gallons; STB 734 Date 8/7/01

Pump Tank: 1000 Gallons; PT 24 Date 9/5/01

Pump Make: _____ Model _____ Serial No. _____

Nitrification Field: No Fields 1 Square Feet 870 Linear Feet 270

No Lines 6 @ 45' Trench Width 24" Max Trench Bottom Depth 36" Gravel Depth —

☒ New System ☐ Repair System Type: I, II, III, IV, V, VI

System Description: Pressure Manifold panel

Repair System Description: LP panel

Maintenance Agreement Required: ☐ Yes ☒ No

☒ House/Mod. Home No. Bedrooms 4

☐ Mobile Home No. Bathrooms 4

☐ Business No. Employees _____

☐ Other _____


☐ Slab ☐ Crawl Space ☒ Basement w/plumbing ☐ Basement wo/plumbing

Water Supply: ☐ Individual ☐ Public ☐ Community

Comments:/Conditions:


150'

INITIAL SITE SKETCH

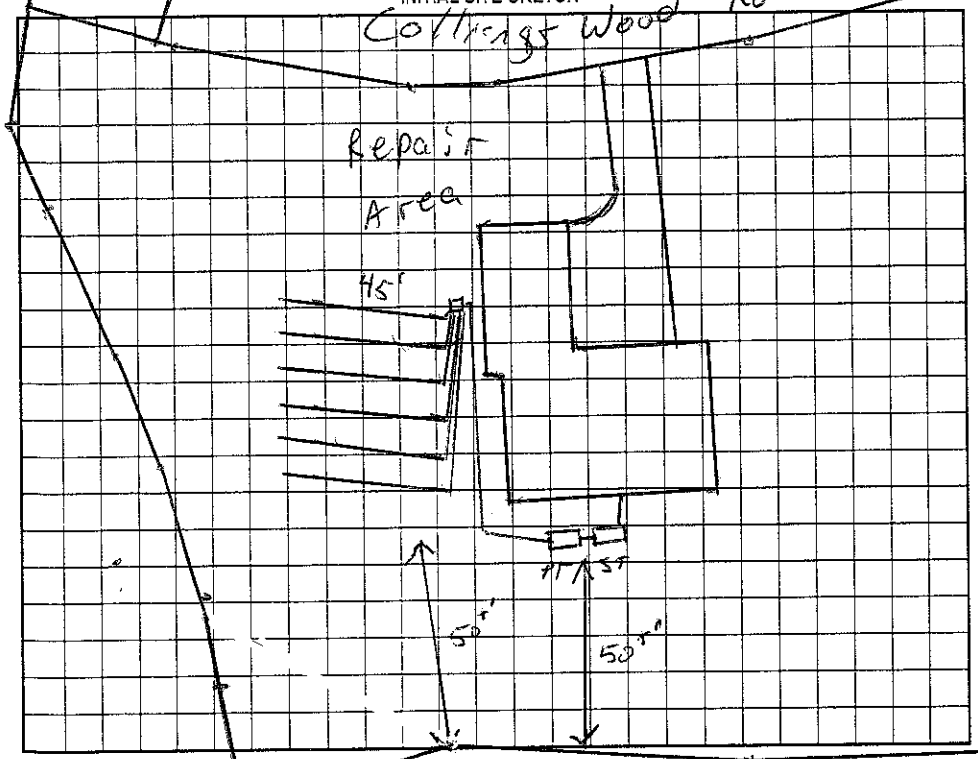

Comments:/Conditions:

AS BUILT SKETCH

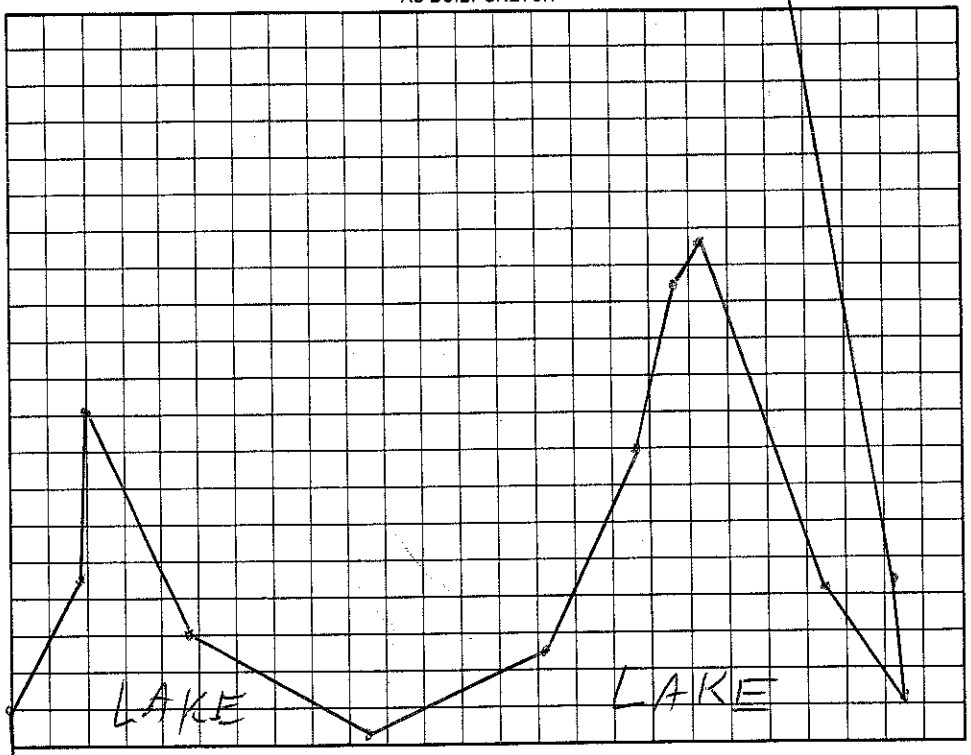

Permit can be suspended or revoked if any false information is supplied toward securing the permit/any unauthorized changes are made to the site/any unauthorized changes are made in the installation of the system. Improvement Permit with plat valid without expiration. Improvement Permit with site plan valid for sixty months. Authorization to Construct is valid for a period equal to that of Improvement Permit – not to exceed sixty months.

Signed: Barry B Auman date 9/4/01

Improvement Permit by: RSI date 8/30/01

Authorization to Construct by: RSI date 8/30/01

Installed by: Charles Beatty

Operation Permit by: RS date 11/5/05

Existing System Inspection by: _____ date _____

HEALTH DEPT. COPY: WHITE OWNER COPY (FINAL): YELLOW OWNER COPY (INITIAL): PINK

IREDELL COUNTY HEALTH DEPARTMENT

STATESVILLE 704-878-5305 50.00 Paid MOORESVILLE 704-664-5281

IMPROVEMENT PERMIT / AUTHORIZATION TO CONSTRUCT / OPERATION PERMIT / EXISTING SYSTEM INSPECTION

PERMIT# 73970 PIN# 4638 57 5218 DATE 6/22/01

OWNER OR CONTRACTOR Barry Auman PHONE: Business _____ Home 799-0768

ADDRESS 470 Statts Rd. Mooresville NC 28117

LOCATION Perth, L Stumpy Crk, L Collingswood Rd, on RT

SUBDIVISION Haustman BLOCK / SECTION _____ LOT 4 LOT AREA 1.57 AC SITE CLASS. PS DESIGN FLOW 480 L.T.A.R. 0.3

Septic Tank: 1060 Gallons; STB _____ Date _____

Pump Tank: 1000 Gallons; PT _____ Date _____

Pump Make: _____ Model _____ Serial No. _____

Nitrification Field: No Fields 1 Square Feet 810 Linear Feet 270

No Lines 5@54' Trench Width 24" Max Trench Bottom Depth 36" Gravel Depth —

☒ New System ☐ Repair System Type: I, II, III, IV, V, VI

System Description: Press. Man. Panel

Repair System Description: LP Panel

Maintenance Agreement Required: ☐ Yes ☒ No

☒ House/Mod. Home No. Bedrooms 4

☐ Mobile Home No. Bathrooms 3

☐ Business No. Employees _____


☐ Other _____

☐ Slab ☐ Crawl Space ☒ Basement w/plumbing ☐ Basement wo/plumbing

Water Supply: ☒ Individual ☐ Public ☐ Community


Comments:/Conditions:

INITIAL SITE SKETCH

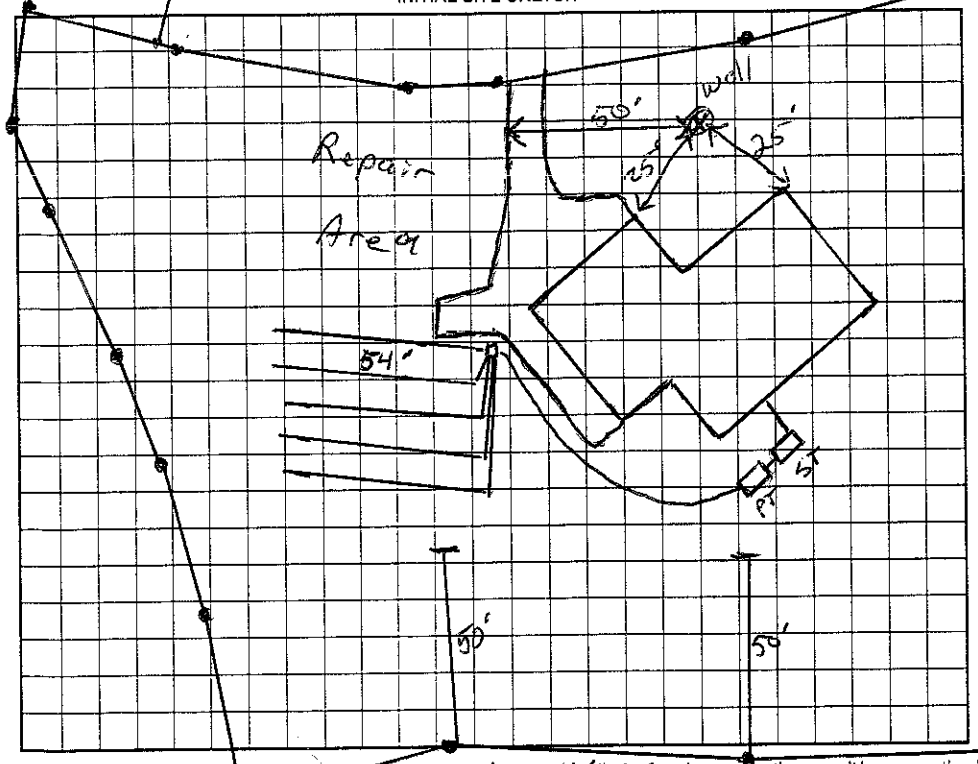

Comments:/Conditions:

AS BUILT SKETCH

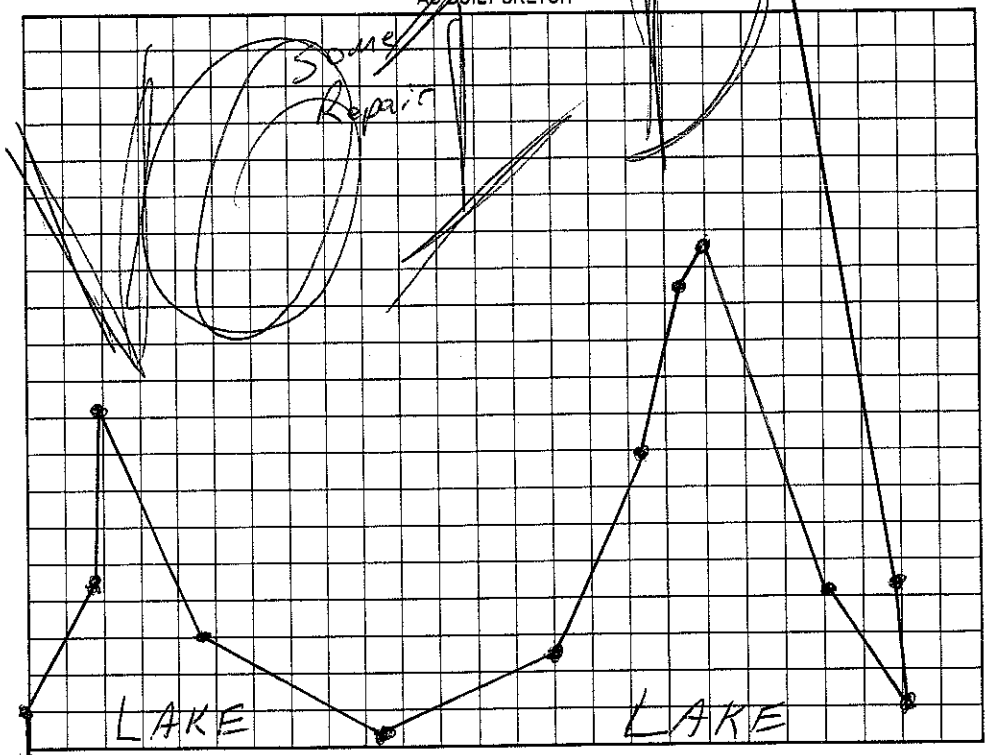

Permit can be suspended or revoked if any false information is supplied toward securing the permit/any unauthorized changes are made to the site/any unauthorized changes are made in the installation of the system. Improvement Permit with plat valid without expiration. Improvement Permit with site plan valid for sixty months. Authorization to Construct is valid for a period equal to that of Improvement Permit – not to exceed sixty months.

Signed: Barry B Auman date 6/25/01 Installed by: _____

Improvement Permit by: RSI date 6/22/01 Operation Permit by: _____ date _____

Authorization to Construct by: RSI date 6/22/01 Existing System Inspection by: _____ date _____

HEALTH DEPT. COPY: WHITE OWNER COPY (FINAL): YELLOW OWNER COPY (INITIAL): PINK

IREDELL COUNTY HEALTH DEPARTMENT

STATESVILLE 704-878-5305 MOORESVILLE 704-664-5281

IMPROVEMENT PERMIT / AUTHORIZATION TO CONSTRUCT / OPERATION PERMIT / EXISTING SYSTEM INSPECTION

PERMIT# 073970 PIN# 4638575220 PT DATE 7/1/98

OWNER OR CONTRACTOR RICHARD HAUSTMAN PHONE: Business Home 664-5220

ADDRESS 194 COLLINGSWOOD RD MOORESVILLE.

LOCATION PERTH RD- TL STUMPY CREEK - TL COLLINGSWOOD - OR RT

SUBDIVISION HAUSTMAN BLOCK / SECTION LOT 1 LOT AREA - SITE CLASS. PS DESIGN FLOW 360 GPD L.T.A.R. .30 AC/FT

Septic Tank: 1000 Gallons; STB Date

Pump Tank: 1000 Gallons; PT Date

Pump Make: Model Serial No.

Nitrification Field: No Fields 1 Square Feet 600 Linear Feet 200

No Lines 4@50' Trench Width 24" Max Trench Bottom Depth 36" Gravel Depth NA

☑ New System ☐ Repair System Type: I, II, III, IV, V, VI

System Description: PUMP PANEL

Repair System Description: SAME

Maintenance Agreement Required: ☐ Yes ☑ No

☑ House/Mod. Home No. Bedrooms 3

☐ Mobile Home No. Bathrooms 2

☐ Business No. Employees

☐ Other


☐ Slab ☐ Crawl Space ☑ Basement w/plumbing ☐ Basement wo/plumbing

Water Supply: ☑ Individual ☐ Public ☐ Community


Comments:/Conditions:

Comments:/Conditions:

INITIAL SITE SKETCH NOT TO SCALE

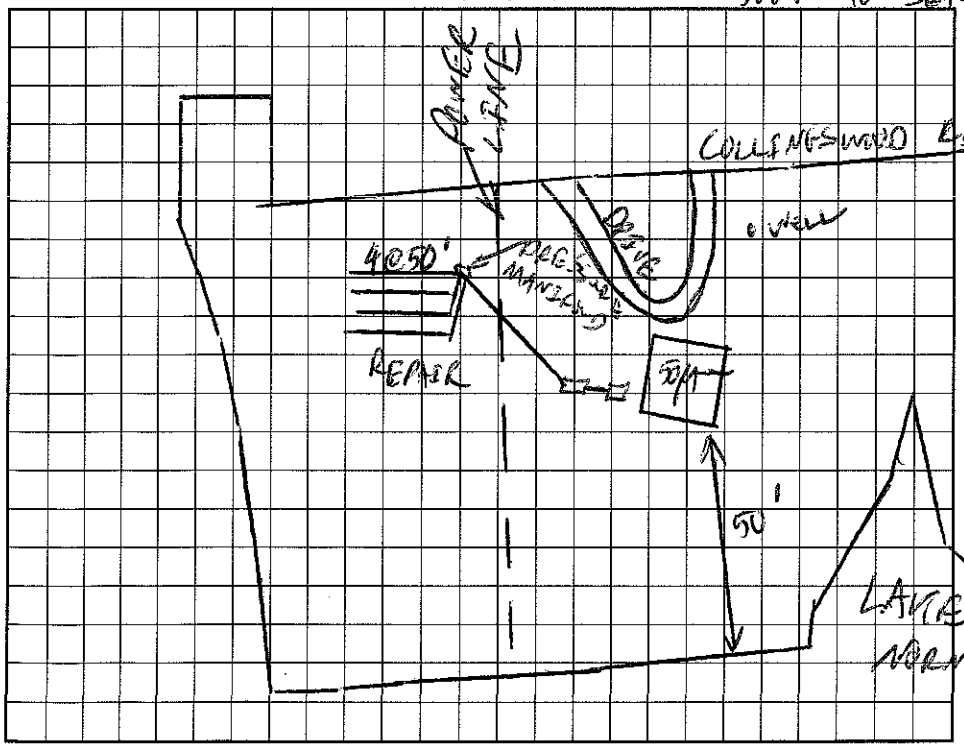

AS BUILT SKETCH

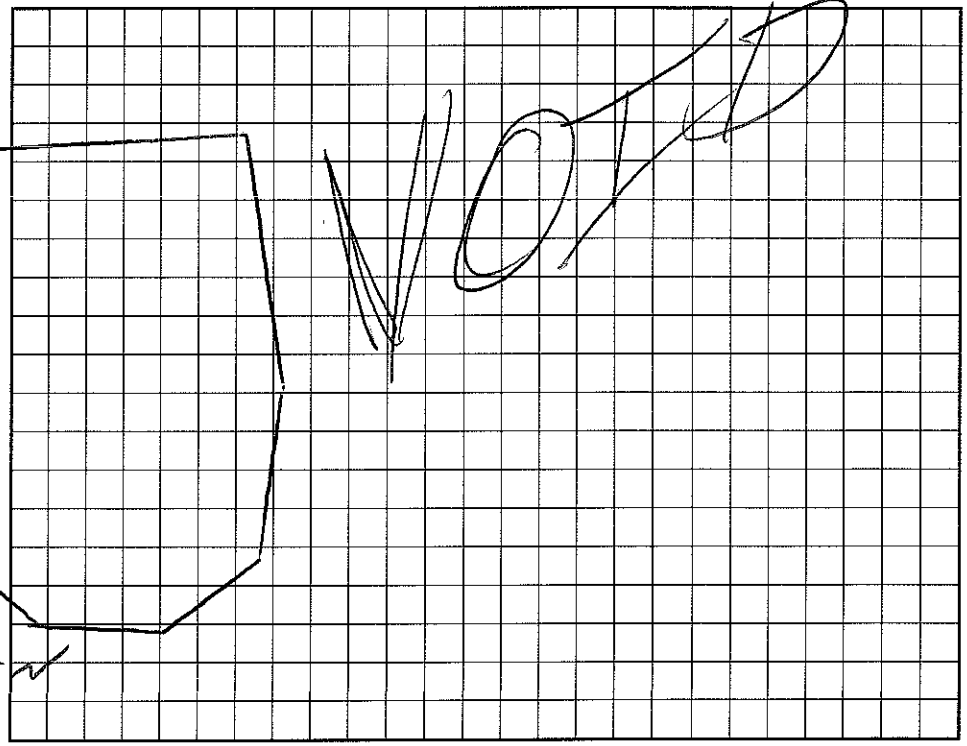

I understand that this permit can be suspended or revoked if any false information is supplied toward securing the permit/any unauthorized changes are made to the site/any unauthorized changes are made in the installation of the system. Improvement Permit with plat valid without expiration. Improvement Permit with site plan valid for sixty months. Authorization to Construct is valid for a period equal to that of Improvement Permit – not to exceed sixty months.

Signed: Richard Haustman date 9-21-98 Installed by:

Improvement Permit by: C. Ryan date 7/1/98 Operation Permit by: date

Authorization to Construct by: C. Ryan date 7/1/98 Existing System Inspection by: date

HEALTH DEPT. COPY: WHITE INSPECTION COPY (FINAL): GREEN OWNER COPY (FINAL): YELLOW INSPECTION COPY (INITIAL): PINK OWNER COPY (INITIAL): GOLD