IREDELL COUNTY HEALTH DEPARTMENT

Construct. Auth. STATESVILLE 704-878-5305 MOORESVILLE 704-664-5281

(300)

IMPROVEMENT PERMIT / CERTIFICATE OF COMPLETION / OPERATION PERMIT / EXISTING SYSTEM INSPECTION

PROPERTY DESCRIPTION NO. 23987 DATE 12-8-97 TAX MAP NO. part of 2SA80 Watershed: X Yes ☐ No

OWNER OR CONTRACTOR David Ring PHONE: Business 895-1968 ~~Home~~ 4638-57-7296

ADDRESS 837 Beaty St Davidson, NC. 28036

LOCATION N.on Perth Rd. left on Stumpy Creek Loop, left on Collingswood 12th lot on left

SUBDIVISION Harbor View BLOCK / SECTION III LOT 210 LOT AREA 1.52 Acre SITE CLASS. PSJ DESIGN FLOW 360 gpd L.T.A.R. ~3

Septic Tank: 1000 Gallons; STB 620 Date 6-1-98

Pump Tank: ____ Gallons; PT ____ Date ____

Pump Make: ____ Model ____ Serial No. ____

Nitrification Field: No Fields 1 Square Feet 1200' Linear Feet 400'

No Lines 5 at 80' Trench Width 36" Max Trench Bottom Depth ~24" Gravel Depth 12"

X New System ☐ Repair System Type: I, (II), III, IV, V, VI

System Description: Gravity, Conventional

Repair System Description: Gravity/Pumped-Modified

Maintenance Agreement Required: ☐ Yes X No

X House/Mod. Home No. Bedrooms 3

☐ Mobile Home No. Bathrooms 2.5

☐ Business No. Employees ____

☐ Other ____

☐ Slab X Crawl Space ☐ Basement w/plumbing ☐ Basement wo/plumbing

Water Supply: ☐ Individual X Community ☐ Public


Comments: Scale 1"=50'

160'


155'

Comments:

INITIAL SITE SKETCH

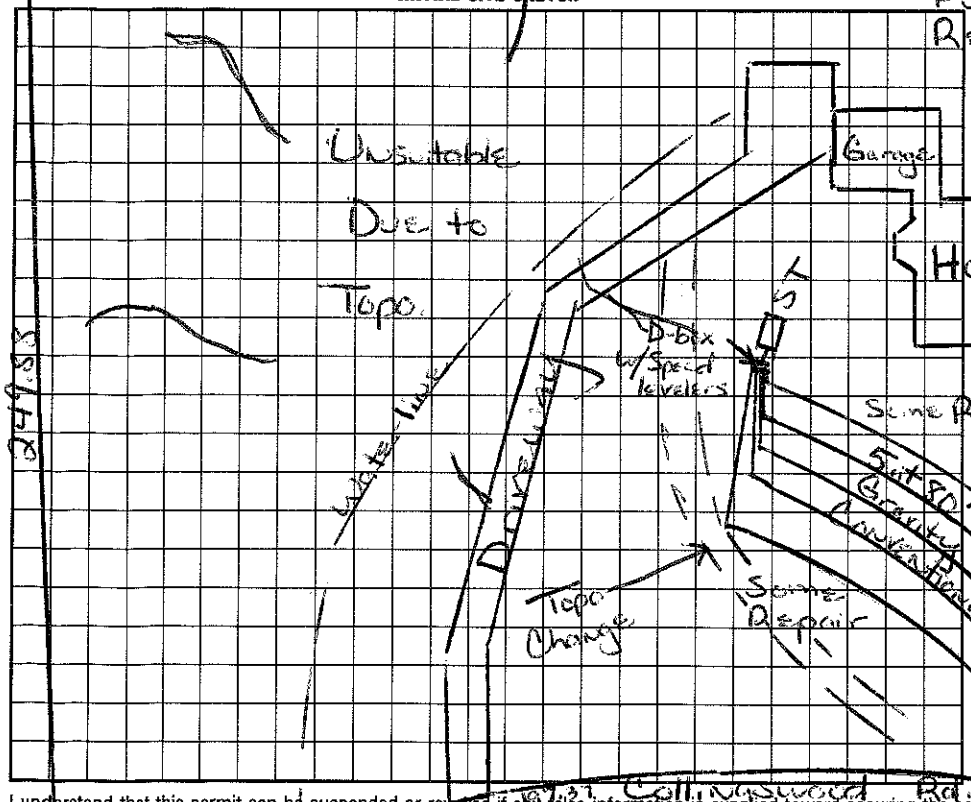

AS BUILT SKETCH

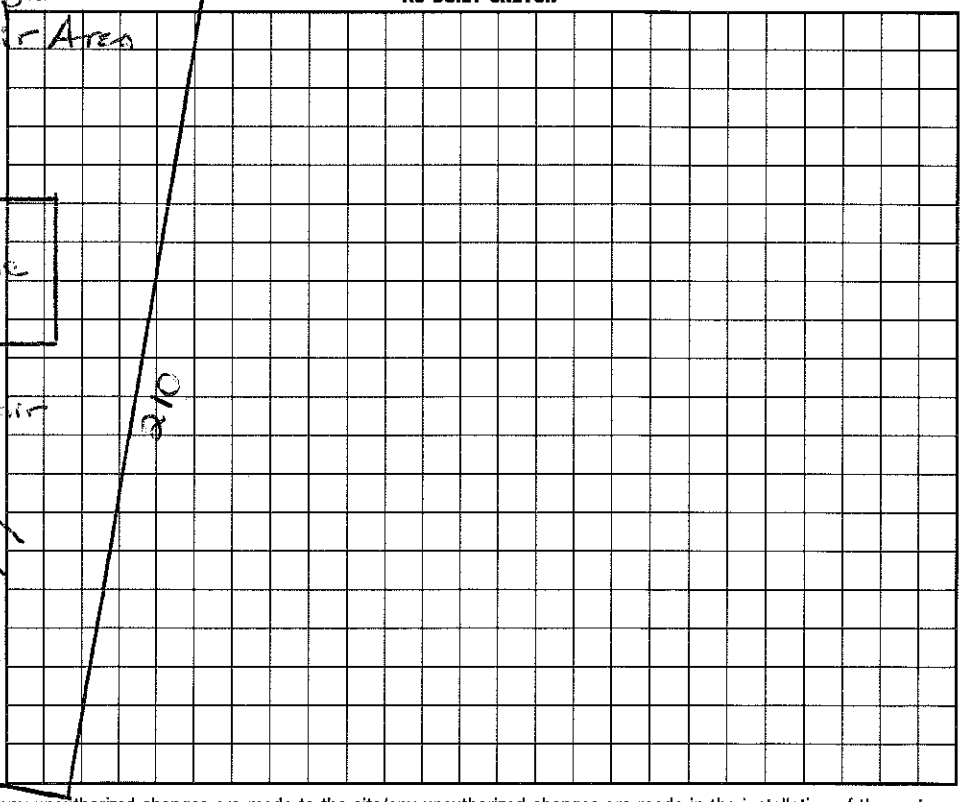

I understand that this permit can be suspended or revoked if any false information is supplied toward securing the permit/any unauthorized changes are made to the site/any unauthorized changes are made in the installation of the system. Improvement Permit is valid for 60 months from date of issuance.

Signed: David Ring 12-9-97 Installed by: Tommy Nixon

Improvement Permit by: Maria H.H. Dotson date 12/8/97

~~Existing System Inspection by:~~ Maria H.H. Dotson date 12/8/97

Certificate of Completion by: ____ date ____

Operation Permit by: C. Ray Fenner RS date 7/16/98

Construct Auth.

HEALTH DEPT. COPY: WHITE INSPECTION COPY (FINAL): GREEN OWNER COPY (FINAL): YELLOW INSPECTION COPY (INITIAL): PINK OWNER COPY (INITIAL): GOLD