IREDELL COUNTY HEALTH DEPARTMENT Const. Auth

STATESVILLE 704-878-5305 MOORESVILLE 704-664-5281

IMPROVEMENT PERMIT / ~~CERTIFICATE OF COMPLETION~~ / OPERATION PERMIT / EXISTING SYSTEM INSPECTION

PROPERTY DESCRIPTION NO. (05203) 23983 / ~~82109~~ DATE Nov. 4 '96 TAX MAP NO. part of 2580 4638 57 7515 Watershed: ☑ Yes ☐ No

OWNER OR CONTRACTOR Stumpy Creek LLC / Bruce Greene PHONE: Business 633-6124 Home

ADDRESS 614 N. Main St. Salisbury NC 28144

LOCATION Perth Rd. N. TL Stumpy Creek TL Collinswood 165 Collinswood Rd

SUBDIVISION Harborviews BLOCK / SECTION III LOT 25 LOT AREA 1.5Ac SITE CLASS PS pre. 1957 DESIGN FLOW 480 gpd L.T.A.R. .3

Septic Tank: 1000 Gallons; STB 794 Date 8/23/61

Pump Tank: 1000 Gallons; PT 27 Date 9/5/61

Pump Make: ZOELLER Model N152A Serial No. 10/25/01

Nitrification Field: No Fields 1 Square Feet 1200 Linear Feet 400

No Lines 5 @ 80' Trench Width 36" Max Trench Bottom Depth 24" Gravel Depth N/A

☑ New System ☐ Repair System Type: I, II, (III) IV, V, VI

System Description: pumped pressure chambered

Repair System Description: same

Maintenance Agreement Required: ☐ Yes ☑ No

☑ House/Mod. Home No. Bedrooms 4

☐ Mobile Home No. Bathrooms 2½

☐ Business No. Employees

☐ Other

☑ Slab ☐ Crawl Space ☐ Basement w/plumbing ☐ Basement wo/plumbing


Water Supply: ☐ Individual ☐ Community ☐ Public

Comments:

Comments: Lines, Tanks, Pressure, & Electrical

1" = 50'

INITIAL SITE SKETCH

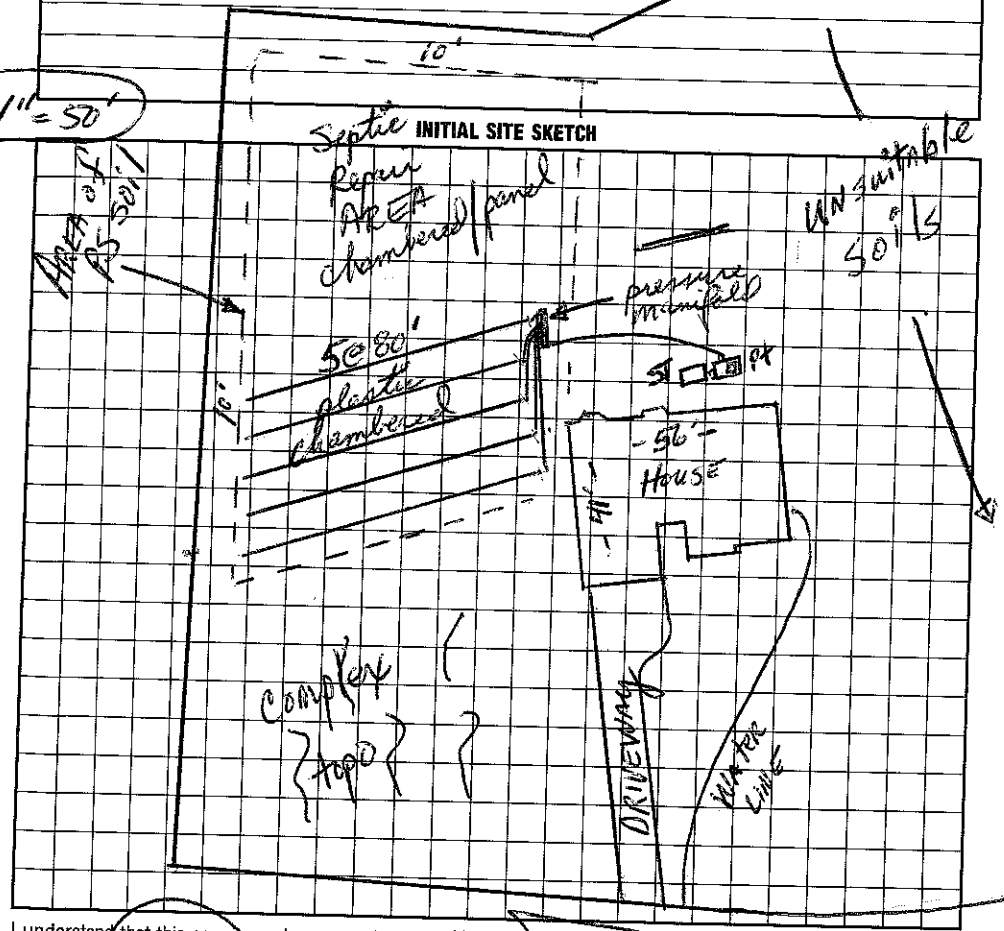

AS BUILT SKETCH

I understand that this permit can be suspended or revoked if any false information is supplied toward securing the permit/any unauthorized changes are made to the site/any unauthorized changes are made in the installation of the system.

Signed:

Improvement Permit by: Mark R. Hanson, RS date 11-4-96

~~Existing System Inspection by:~~ CONSTRUCTION

Final: Mark R. Hanson, RS date 8-6-99

Installed by: Larry Beaver

Certificate of Completion by: Wesley Sparks RS date 10/26/01

Operation Permit by: date

Pattern: 2 Initial

HEALTH DEPT. COPY: WHITE INSPECTION COPY (FINAL): GREEN OWNER COPY (FINAL): YELLOW INSPECTION COPY (INITIAL): PINK OWNER COPY (INITIAL): GOLD