10:30

# IREDELL COUNTY HEALTH DEPARTMENT Const. Auth

STATESVILLE 704-878-5305 MOORESVILLE 704-664-5281

## IMPROVEMENT PERMIT / ~~CERTIFICATE OF COMPLETION~~ / OPERATION PERMIT / EXISTING SYSTEM INSPECTION

PROPERTY DESCRIPTION NO. 23982 DATE Nov 5, '96 TAX MAP NO. Part of 2SA80 Watershed: ☑ Yes ☐ No

OWNER OR CONTRACTOR Stumpy Creek LLC (Miller Const. Co) PHONE: Business 633-6124 ~~Home~~ 4638-57-7714

ADDRESS 614 N. Main Salisbury NC 28144

LOCATION Perth Rd. N. TL Stumpy Creek Rd. TL Collingswood 10th lot left

SUBDIVISION Hurbanview BLOCK / SECTION III LOT 24 (24) LOT AREA .59 SITE CLASS. PS prg. 1952 DESIGN FLOW 480 gpd L.T.A.R. ~.3

Septic Tank: 1000 Gallons; STB 794 Date 6-13-97

Pump Tank: _____ Gallons; PT _____ Date _____

Pump Make: _____ Model _____ Serial No. _____

Nitrification Field: No Fields 1 Square Feet 1200 Linear Feet 400

No Lines 5@80' Trench Width 36" Max Trench Bottom Depth ~ 24" Gravel Depth N/A

☑ New System ☐ Repair System Type: I, II, III, IV, V, VI

System Description: gravity w/ septic chambered

Repair System Description: pumped chambered repair

Maintenance Agreement Required: ☐ Yes ☑ No

☑ House/Mod. Home No. Bedrooms 4

☐ Mobile Home No. Bathrooms 2½

☐ Business No. Employees _____

☐ Other _____


☑ Slab ☐ Crawl Space ☐ Basement w/plumbing ☐ Basement wo/plumbing

Water Supply:
☐ Individual
☑ Community
☐ Public

Comments:

Comments:

**INITIAL SITE SKETCH** 1"=50'

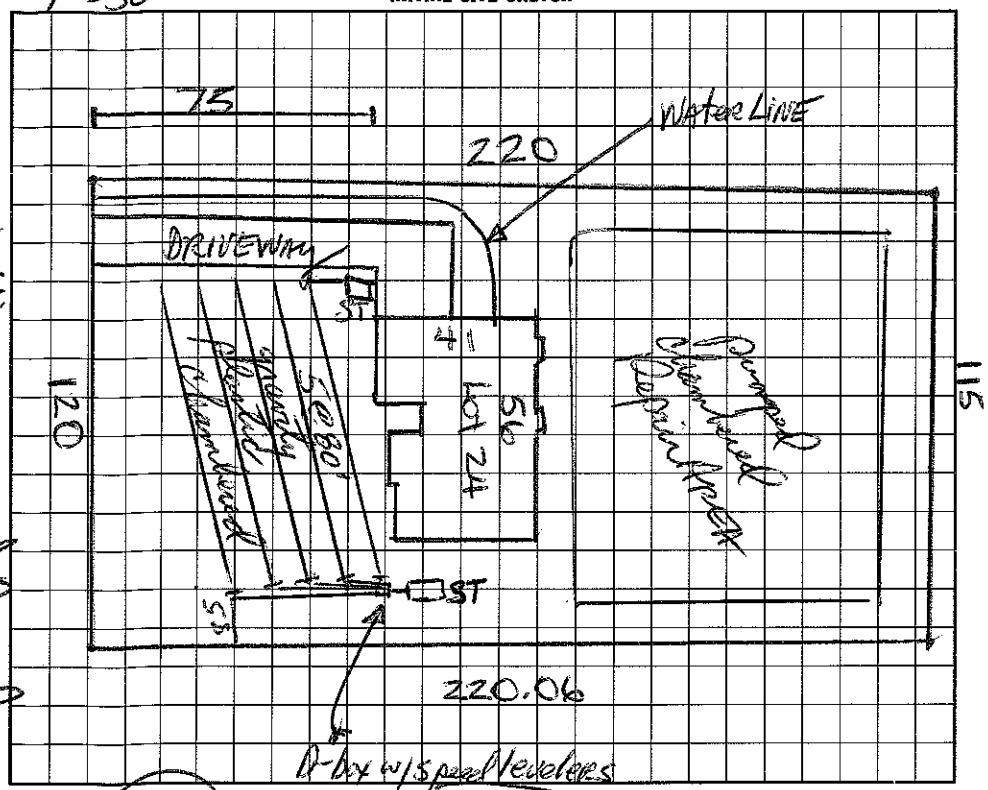


**AS BUILT SKETCH**

Installed as drawn

Except Septic Tank (ST)

On Opposite Side of House

I understand that this permit can be suspended or revoked if any false information is supplied toward securing the permit/any unauthorized changes are made to the site/any unauthorized changes are made in the installation of the system.

Signed: _____

Improvement Permit by: Marcel Hunter RS date 11-5-96

Construction ~~Existing System~~ Inspection by: Wendy Sparks RS date 2/27/97

As Installation

Installed by: Larry Hinkle

Certificate of Completion by: Main HH Dotson date 9/9/97

Operation Permit by: Main HH Dotson date 9/9/97

HEALTH DEPT. COPY: WHITE INSPECTION COPY (FINAL): GREEN OWNER COPY (FINAL): YELLOW INSPECTION COPY (INITIAL): PINK OWNER COPY (INITIAL): GOLD