4638577826

# IREDELL COUNTY HEALTH DEPARTMENT Const. Auth. STATESVILLE 704-878-5305 MOORESVILLE 704-664-5281

## IMPROVEMENT PERMIT / ~~CERTIFICATE OF COMPLETION~~ / OPERATION PERMIT / EXISTING SYSTEM INSPECTION

PROPERTY DESCRIPTION NO. 23981 DATE April 24, '97 TAX MAP NO. part of 2548C Watershed: ☐ Yes ☐ No

OWNER OR CONTRACTOR Stumpy Creek LLC PHONE: Business 633-6124 Home

ADDRESS 614 N. Main Ave Salisbury

LOCATION Path Rd N. TL Stumpy Creek TL Collingswood 4th Lot on left

SUBDIVISION Hiddenview BLOCK / SECTION III LOT 23 LOT AREA 21,780 sq ft SITE CLASS. B DESIGN FLOW 360 gpd L.T.A.R. .13

Septic Tank: 1000 Gallons; STB 825 Date 5/17/97

Pump Tank: _____ Gallons; PT _____ Date _____

Pump Make: _____ Model _____ Serial No. _____

Nitrification Field: No Fields 1 Square Feet 900 Linear Feet 300

No Lines 4@75' Trench Width 36" Max Trench Bottom Depth 24" Gravel Depth N/A

☑ New System ☐ Repair System Type: I, II, III, IV, V, VI

System Description: gravity chamber

Repair System Description: pumped conventional

Maintenance Agreement Required: ☐ Yes ☑ No

☑ House/Mod. Home ☐ Mobile Home ☐ Business ☐ Other

No. Bedrooms 3 No. Bathrooms 2 No. Employees _____

☑ Slab ☐ Crawl Space ☐ Basement w/plumbing ☐ Basement wo/plumbing


Water Supply: ☐ Individual ☑ Community ☐ Public

Comments:


Comments:

1"=60'

**INITIAL SITE SKETCH**

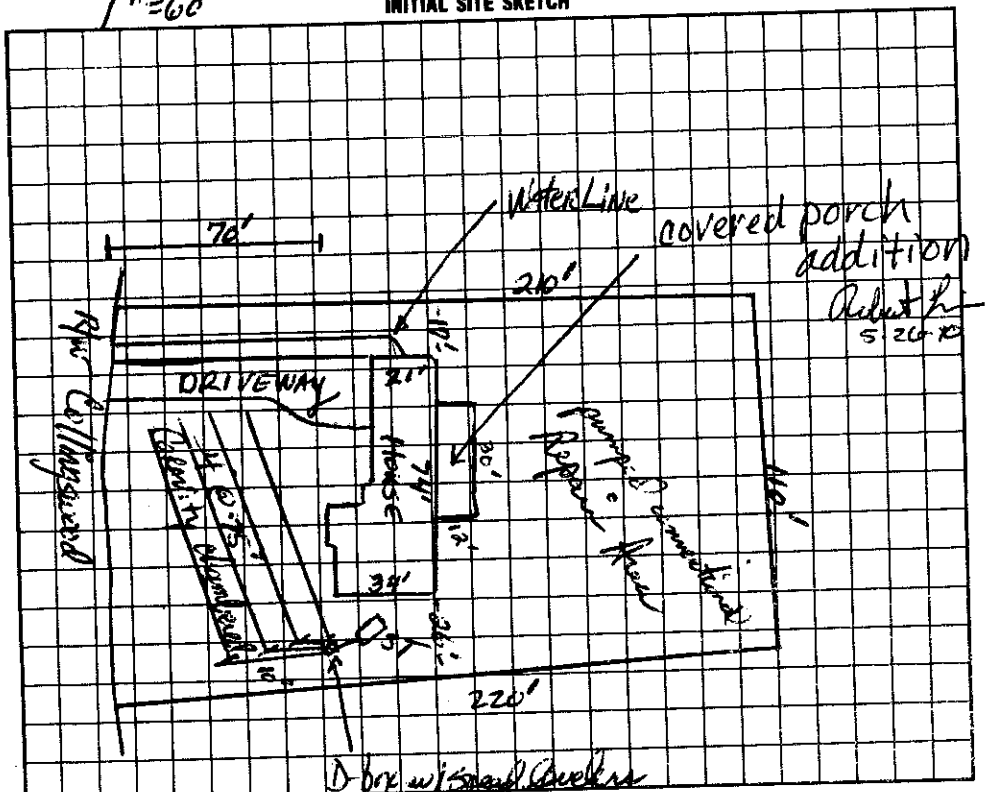


**AS BUILT SKETCH**

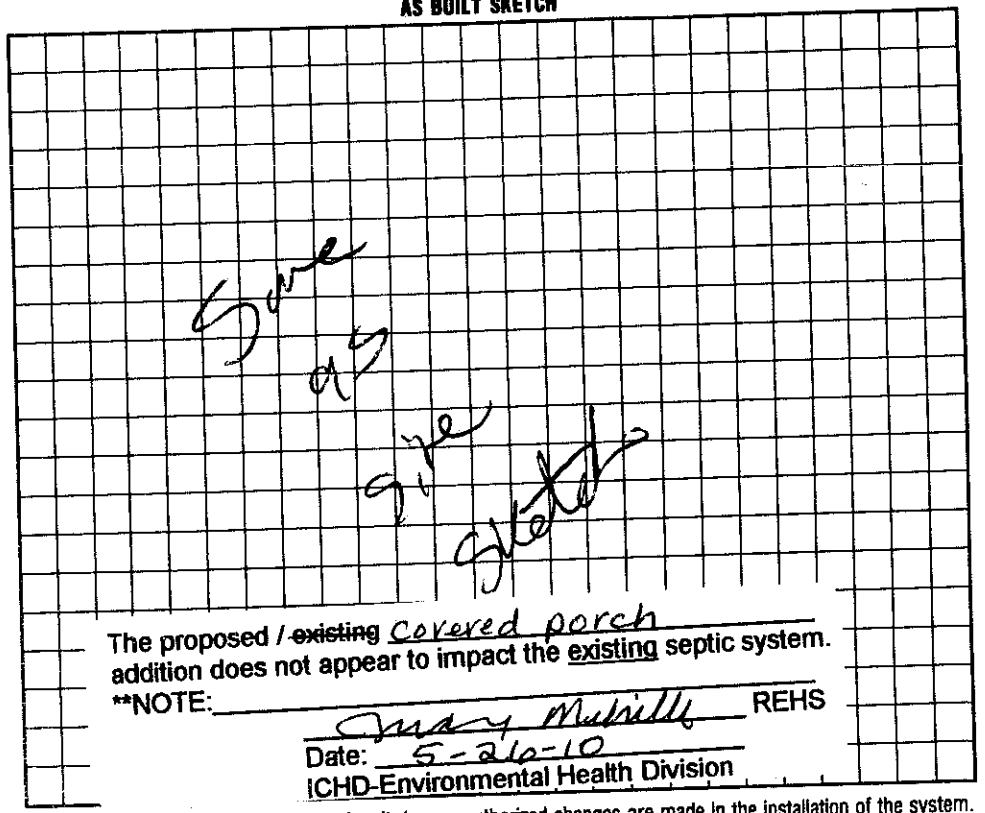

The proposed / ~~existing~~ covered porch addition does not appear to impact the existing septic system.

**NOTE: Mary Mutrille REHS

Date: 5-26-10

ICHD-Environmental Health Division

I understand that this permit can be suspended or revoked if any false information is supplied toward securing the permit/any unauthorized changes are made to the site/any unauthorized changes are made in the installation of the system. Improvement Permit is valid for 60 months from date of issuance.

Signed: _____

Improvement Permit by: _____ date 4/24/97

Construction Authorization by: _____ date 4/24/97

Installed by: ROWAN SEPTIC

Certificate of Completion by: _____ date _____

Operation Permit by: _____ date 7/31/97

OWNER COPY (INITIAL); GOLD