(4)

IREDELL COUNTY HEALTH DEPARTMENT Const. Auth

STATESVILLE 704-878-5305 MOORESVILLE 704-664-5281

IMPROVEMENT PERMIT / ~~CERTIFICATE OF COMPLETION~~ / OPERATION PERMIT / EXISTING SYSTEM INSPECTION

PROPERTY DESCRIPTION NO. 23980 DATE Nov. 5, '96 TAX MAP NO. part of 23480 Watershed: ☒ Yes ☐ No

OWNER OR CONTRACTOR Stumpy Creek LLC - (GAGLE) PHONE: Business 633-6124 ~~Home~~ 4638-57-7967

ADDRESS 614 N. Main Salisbury NC 28144

LOCATION Perth Rd. W. TL Stumpy Creek Rd TL Collingswood 7th lot on left 1st lot

SUBDIVISION Harborview BLOCK / SECTION III LOT 22 LOT AREA ±.55 SITE CLASS. B Spec 1956 DESIGN FLOW 460 gpd L.T.A.R. ~.3 3BDRM

Septic Tank: 1000 Gallons; STB 794 Date 10/13/98

Pump Tank: ____ Gallons; PT ____ Date ____

Pump Make: ____ Model ____ Serial No. ____

Nitrification Field: No Fields 1 Square Feet 1200 Linear Feet 400

No Lines 4 @ 100' Trench Width 36" Max Trench Bottom Depth ~24" Gravel Depth N/A

☒ New System ☐ Repair System Type: I, II, III, IV, V, VI

System Description: gravity plastic chambered

Repair System Description: gravity pumped chambered

Maintenance Agreement Required: ☐ Yes ☒ No

☒ House/Mod. Home ☐ Mobile Home ☐ Business ☐ Other

No. Bedrooms 4 No. Bathrooms 2½ No. Employees ____

☒ Slab ☐ Crawl Space ☐ Basement w/plumbing ☐ Basement wo/plumbing


Water Supply: ☐ Individual ☒ Community ☐ Public

Comments: Changed to 400' of Conventional or 300' feet of Ch. Plastic - 1/26/99 AWS.

Comments:

1"=50'

INITIAL SITE SKETCH

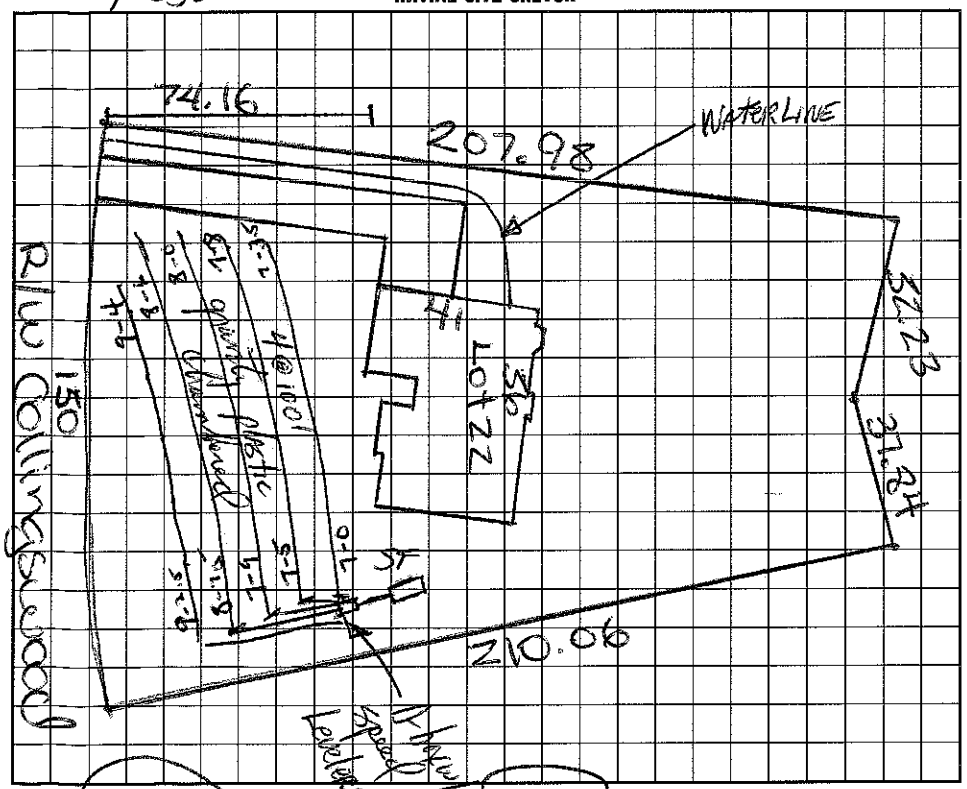

AS BUILT SKETCH

I understand that this permit can be suspended or revoked if any false information is supplied toward securing the permit/any unauthorized changes are made to the site/any unauthorized changes are made in the installation of the system.

Signed: ____

Improvement Permit by: Mark L. Hinson RS date 11-5-96

Existing System Inspection by: Wesley Sparks RS. date 7/8/98

Installed by: F J Ervin

Certificate of Completion by: Wesley Sparks RS. date 1/28/99

Operation Permit by: ____ date ____

Construction Authorization

HEALTH DEPT. COPY: WHITE INSPECTION COPY (FINAL): GREEN OWNER COPY (FINAL): YELLOW INSPECTION COPY (INITIAL): PINK OWNER COPY (INITIAL): GOLD