IREDELL COUNTY HEALTH DEPARTMENT

STATESVILLE 704-878-5305 MOORESVILLE 704-664-5281

IMPROVEMENT PERMIT / AUTHORIZATION TO CONSTRUCT / OPERATION PERMIT / EXISTING SYSTEM INSPECTION

PERMIT# 23988 PIN# 2580 PT 4638-57-8006 DATE 2/2/98

OWNER OR CONTRACTOR LONG BUILDERS PHONE: Business 336-468 2627 Home

ADDRESS 6540 WINDSOR RD HAMPTONVILLE NC 27020

LOCATION PERTH N- TL STUMPY CREEK - TL COLLINSWOOD - ON LT

SUBDIVISION HARBORVIEW BLOCK / SECTION III LOT 27 LOT AREA .69AC SITE CLASS. PS DESIGN FLOW 360GPD L.T.A.R. .30GPD/FT²

Septic Tank: 1000 Gallons; STB 928 Date 5/11/98

Pump Tank: Gallons; PT Date

Pump Make: Model Serial No.

Nitrification Field: No Fields 1 Square Feet 1200 Linear Feet 400

No Lines 4@100' Trench Width 36" Max Trench Bottom Depth 24 Gravel Depth 12"

☑ New System ☐ Repair System Type: I (II) III, IV, V, VI

System Description: GRAVITY CONVENTIONAL

Repair System Description: CHAMBERED DRAINS

Maintenance Agreement Required: ☐ Yes ☑ No

☑ House/Mod. Home No. Bedrooms 3

☐ Mobile Home No. Bathrooms 2

☐ Business No. Employees

☐ Other


☐ Slab ☑ Crawl Space ☐ Basement w/plumbing ☐ Basement wo/plumbing

Water Supply: ☐ Individual ☑ Public ☑ Community

Comments:/Conditions:

Comments:/Conditions:

INITIAL SITE SKETCH 1"=50'

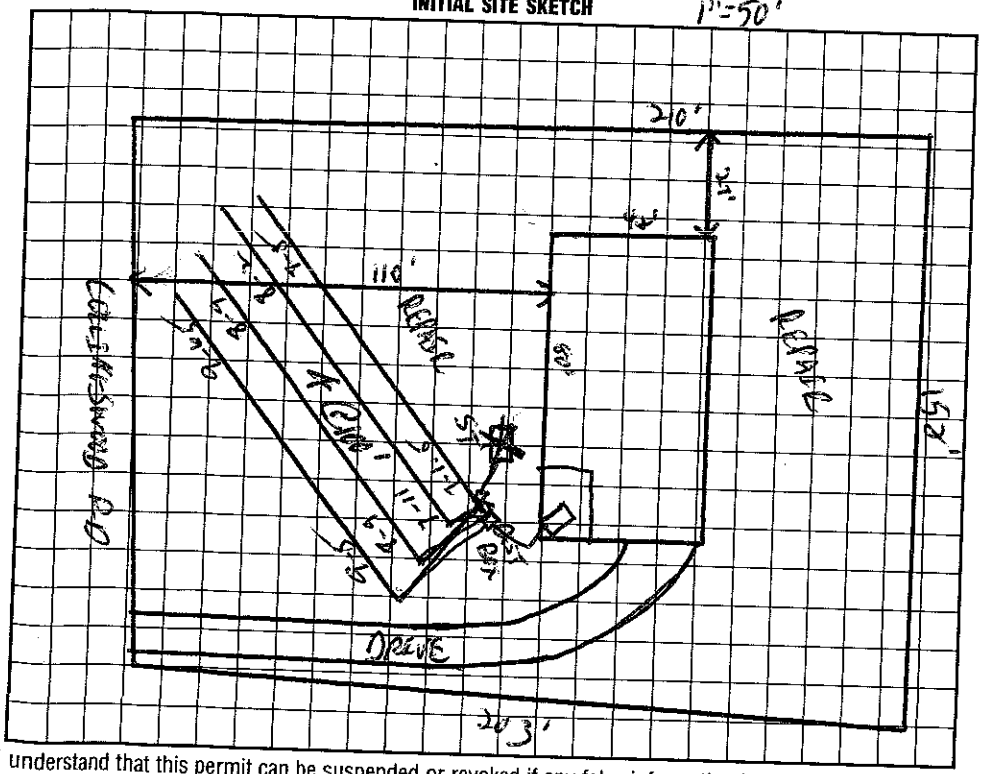

AS BUILT SKETCH

I understand that this permit can be suspended or revoked if any false information is supplied toward securing the permit/any unauthorized changes are made to the site/any unauthorized changes are made in the installation of the system. Improvement Permit with plat valid without expiration. Improvement Permit with site plan valid for sixty months. Authorization to Construct is valid for a period equal to that of Improvement Permit – not to exceed sixty months.

Signed: Larry Burleson John F. Long date 2-3-98

Improvement Permit by: RS date 2/2/98

Authorization to Construct by: RS date 2/3/98

Installed by: Tommy Hinson

Operation Permit by: Wesley Sparks RS. date 7/10/98

Existing System Inspection by: Wesley Sparks RS date 7/10/98

HEALTH DEPT. COPY: WHITE INSPECTION COPY (FINAL): GREEN OWNER COPY (FINAL): YELLOW INSPECTION COPY (INITIAL): PINK OWNER COPY (INITIAL): GOLD