IREDELL COUNTY HEALTH DEPARTMENT

Const. Auth. STATESVILLE 704-878-5305 MOORESVILLE 704-664-5281

2.00

IMPROVEMENT PERMIT / ~~CERTIFICATE OF COMPLETION~~ / OPERATION PERMIT / EXISTING SYSTEM INSPECTION

PROPERTY DESCRIPTION NO. 066583 DATE Nov. 17 '97 TAX MAP NO. 4638771716 (pts) Watershed: ☑ Yes ☐ No

OWNER OR CONTRACTOR Stumpy Creek LLC PHONE: Business 633-6124 ~~Home~~ 4638-57-9533

ADDRESS 614 N. main St. Salisbury

LOCATION Perth Rd. N. TL Stumpy Creek TL Kiskadee Dr. at end on Right

SUBDIVISION Harborview BLOCK / SECTION 9 LOT 12 LOT AREA .71 Ac. SITE CLASS PS DESIGN FLOW 360 gpd L.T.A.R. ~.3

Septic Tank: 1000 Gallons; STB 714 Date 2/19/97

Pump Tank: ____ Gallons; PT ____ Date ____

Pump Make: ____ Model 900 Serial No. ____

Nitrification Field: No Fields 1 Square Feet 1200 Linear Feet ~~400~~ 300

No Lines 4@100' Trench Width 36" Max Trench Bottom Depth 24" Gravel Depth 12"

☑ New System ☐ Repair System Type: I, II, III, IV, V, VI

System Description: gravity conventional chambers

Repair System Description: gravity pumped conventional

Maintenance Agreement Required: ☐ Yes ☑ No

☑ House/Mod. Home No. Bedrooms 3

☐ Mobile Home No. Bathrooms 2

☐ Business No. Employees ____

☐ Other ____

☐ Slab ☑ Crawl Space ☐ Basement w/plumbing ☐ Basement wo/plumbing


Water Supply: ☐ Individual ☑ Community ☐ Public

Comments: 5@60'


Comments: (change to chambers) (5@60) or (62.5 ft)

1" = 60'

INITIAL SITE SKETCH

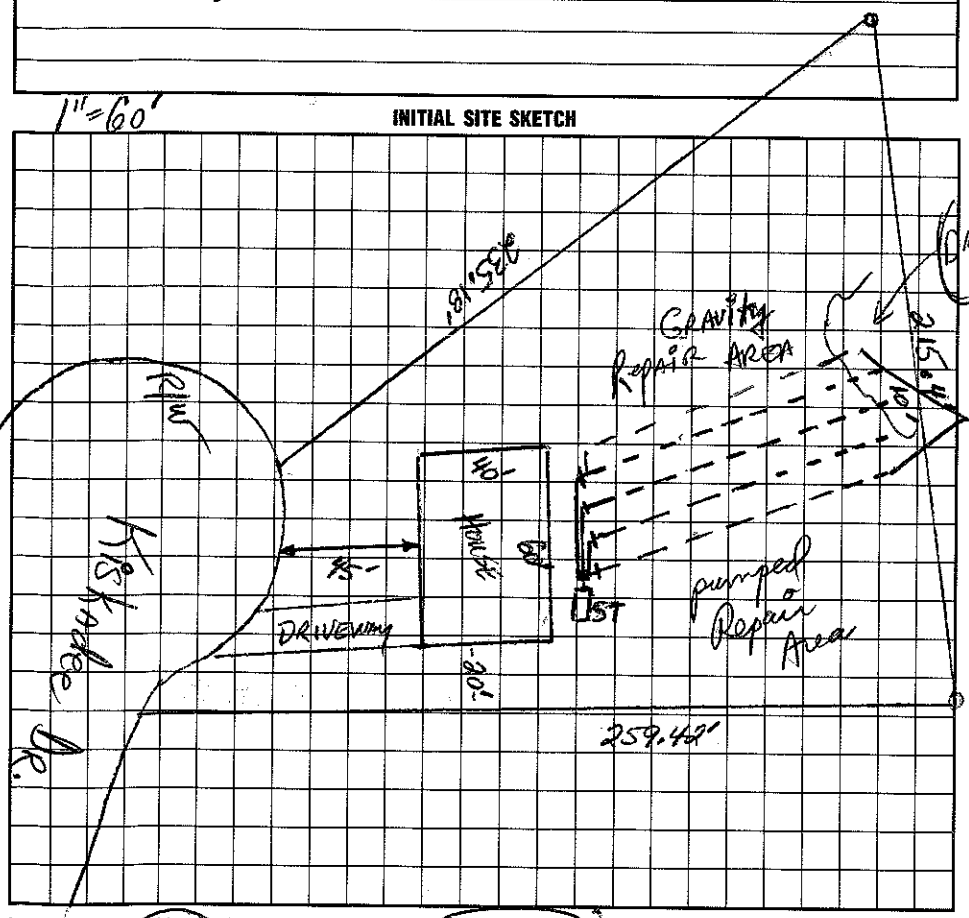

AS BUILT SKETCH

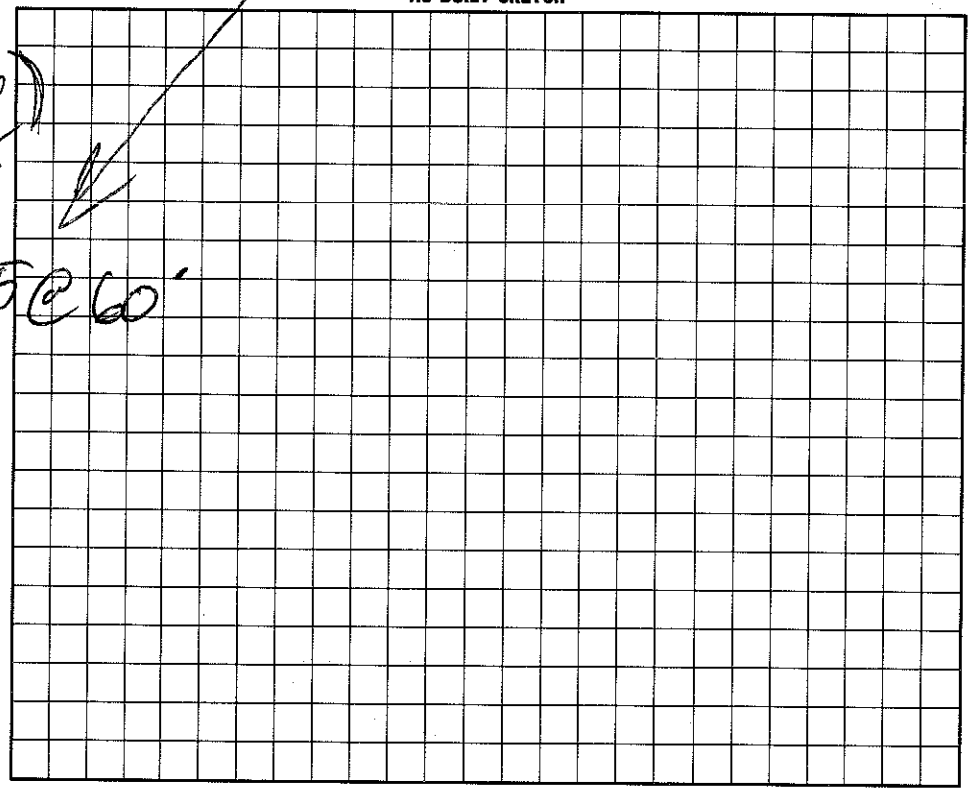

I understand that this permit can be ~~suspended~~ or revoked if any false information is supplied toward securing the permit/any unauthorized changes are made to the site/any unauthorized changes are made in the installation of the system. ~~Improvement~~ Permit is valid for 60 months from date of issuance.

Signed: ____

Improvement Permit by: ____ date 11-17-97

~~Existing System Inspection~~ Construction Authorization by: ____ date 4/1/98

Installed by: Larry Beam

Certificate of Completion by: ____ date 8/2/99

Operation Permit by: ____ date ____

HEALTH DEPT. COPY: WHITE INSPECTION COPY (FINAL): GREEN OWNER COPY (FINAL): YELLOW INSPECTION COPY (INITIAL): PINK OWNER COPY (INITIAL): GOLD