IREDELL COUNTY HEALTH DEPARTMENT

STATESVILLE 704-878-5305 MOORESVILLE 704-664-5281

IMPROVEMENT PERMIT / AUTHORIZATION TO CONSTRUCT / OPERATION PERMIT / EXISTING SYSTEM INSPECTION

PERMIT# 066582 PIN# ~~4638 77 7116 PL.~~ 4638-57-9658 DATE 3/1/99

OWNER OR CONTRACTOR Stumpy Creek LLC (HARPER CONST.) PHONE: Business 478-3766 Home

ADDRESS 1651 Lebi Forest Dr. Catawba, N.C. 28609

LOCATION Perth N TL Stumpy Creek TL Kiskadee Dr., on (R) before cul de sac

SUBDIVISION HARBORVIEW BLOCK / SECTION 9 LOT 11 LOT AREA ~.86 Ac SITE CLASS. PS DESIGN FLOW 360 L.T.A.R. .3

Septic Tank: 1000 Gallons; STB 774 Date 1-20-97
Pump Tank: Gallons; PT Date
Pump Make: Model Serial No.
Nitrification Field: No Fields 1 Square Feet 900 * Linear Feet 300 *
No Lines 4@75' Trench Width 36" Max Trench Bottom Depth 36" Gravel Depth SAND.


[X] New System [ ] Repair System Type: I, II, (III) IV, V, VI
System Description: Gravity - Ch. PLASTIC
Repair System Description: Pressure - Type III
Maintenance Agreement Required: [ ] Yes [X] No

[X] House/Mod. Home No. Bedrooms 3
[ ] Mobile Home No. Bathrooms 3
[ ] Business No. Employees
[ ] Other
[ ] Slab [X] Crawl Space [ ] Basement w/plumbing [ ] Basement wo/plumbing

Water Supply: [ ] Individual [ ] Public [X] Community

Comments:/Conditions:

INITIAL SITE SKETCH

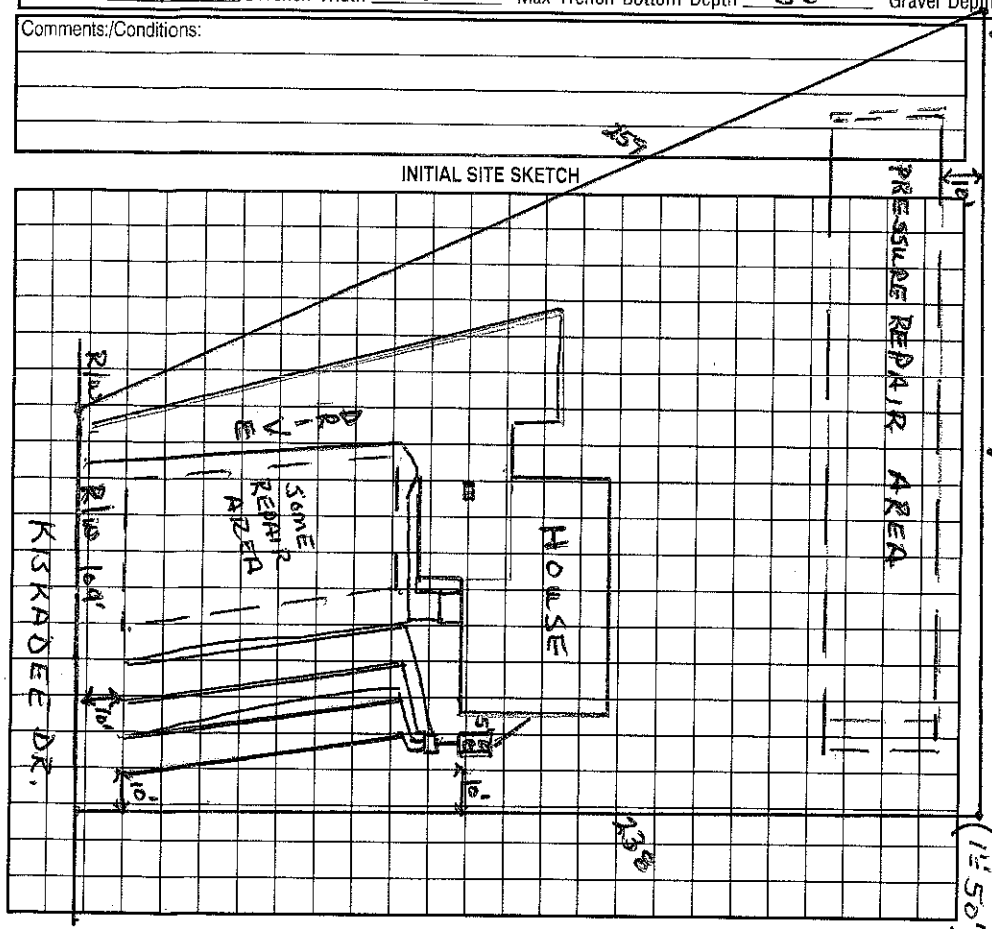

Comments:/Conditions:

AS BUILT SKETCH

Permit can be suspended or revoked if any false information is supplied toward securing the permit/any unauthorized changes are made to the site/any unauthorized changes are made in the installation of the system. Improvement Permit with plat valid without expiration. Improvement Permit with site plan valid for sixty months. Authorization to Construct is valid for a period equal to that of Improvement Permit – not to exceed sixty months.

Signed: * Mark Harper date 3/8/99

Improvement Permit by: Wesley Sparks R.S. date 3/1/99

Authorization to Construct by: Wesley Sparks R.S. date 3/1/99

Installed by: LARRY BEAM

Operation Permit by: [signature] date 3/9/99

Existing System Inspection by: date

HEALTH DEPT. COPY: WHITE OWNER COPY (FINAL): YELLOW OWNER COPY (INITIAL): PINK