IREDELL COUNTY HEALTH DEPARTMENT

STATESVILLE 704-878-5305 MOORESVILLE 704-664-5281

IMPROVEMENT PERMIT / AUTHORIZATION TO CONSTRUCT / OPERATION PERMIT / EXISTING SYSTEM INSPECTION

PERMIT# 066581 PIN# ~~4638771776 (pt)~~ 4638-57-9871 DATE 10/1/98

OWNER OR CONTRACTOR STUMPY CREEK LLC PHONE: Business _____ Home _____

ADDRESS 614 N. MAIN SALISBURY

LOCATION PERTH RD - TL STUMPY CREEK - TL KESHAGE ON RT

SUBDIVISION HARBORVIEW BLOCK / SECTION 1 LOT 10 LOT AREA .7AC SITE CLASS. PS DESIGN FLOW 360GPD L.T.A.R. .3GPD/FT

Septic Tank: 1000 Gallons; STB 794 Date 7/16/98
Pump Tank: _____ Gallons; PT _____ Date _____
Pump Make: _____ Model _____ Serial No. _____
Nitrification Field: No Fields 1 Square Feet 900 Linear Feet 300
No Lines 6 @ 50 Trench Width 36" Max Trench Bottom Depth 36" Gravel Depth N/A

☑ New System ☐ Repair System Type: I, II, (III), IV, V, VI
System Description: GRAVITY CHAMBER OR HDS
Repair System Description: PUMP SAME
Maintenance Agreement Required: ☐ Yes ☑ No

☑ House/Mod. Home No. Bedrooms 3
☐ Mobile Home No. Bathrooms 2
☐ Business No. Employees _____
☐ Other _____
☐ Slab ☐ Crawl Space ☐ Basement w/plumbing ☐ Basement wo/plumbing


Water Supply:
☐ Individual
☐ Public
☑ Community

Comments:/Conditions:

57 75
S10 83
64

Comments:/Conditions:

INITIAL SITE SKETCH 1"=60'

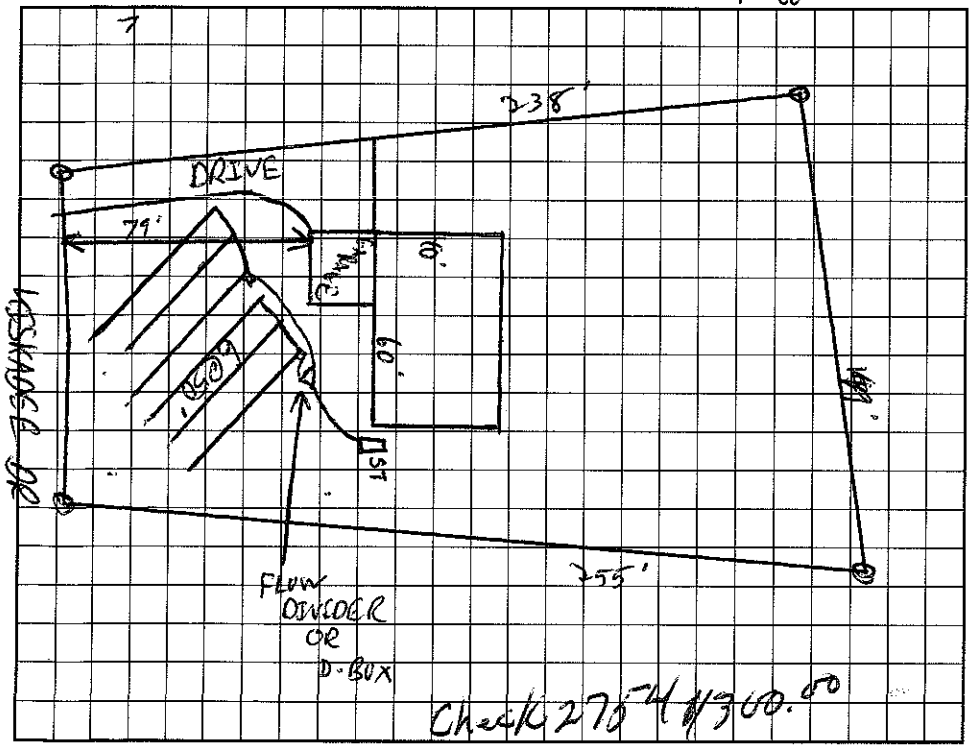

AS BUILT SKETCH

I understand that this permit can be suspended or revoked if any false information is supplied toward securing the permit/any unauthorized changes are made to the site/any unauthorized changes are made in the installation of the system. Improvement Permit with plat valid without expiration. Improvement Permit with site plan valid for sixty months. Authorization to Construct is valid for a period equal to that of Improvement Permit – not to exceed sixty months.

Signed: For Mark Harper date _____ Installed by: LARRY BEAM

Improvement Permit by: RS date 10/1/98 Operation Permit by: RS date 10/2/98

Authorization to Construct by: RS date 10/1/98 Existing System Inspection by: _____ date _____

HEALTH DEPT. COPY: WHITE INSPECTION COPY (FINAL): GREEN OWNER COPY (FINAL): YELLOW INSPECTION COPY (INITIAL): PINK OWNER COPY (INITIAL): GOLD