IREDELL COUNTY HEALTH DEPARTMENT Const. Auth

STATESVILLE 704-878-5305 MOORESVILLE 704-664-5281

IMPROVEMENT PERMIT / ~~CERTIFICATE OF COMPLETION~~ / OPERATION PERMIT / EXISTING SYSTEM INSPECTION

PROPERTY DESCRIPTION NO. 23979 DATE Sept. 29, 197 TAX MAP NO. part of 25A80 Watershed: ☑ Yes ☐ No

OWNER OR CONTRACTOR Eric Krapovicky PHONE: ~~Business~~ 4638-58-8027 Home 483-7119

ADDRESS 1777 Knights Rd. Denver NC 28037

LOCATION SOW. 4R Perth Rd. TL Stumpy Creek TL Collingswood 1st on left

SUBDIVISION Harbourview BLOCK / SECTION III LOT 21 LOT AREA .58AC SITE CLASS. PS DESIGN FLOW 360 gpd L.T.A.R. .3

Septic Tank: 1000 Gallons; STB 794 Date 5/6/98

Pump Tank: _____ Gallons; PT _____ Date _____

Pump Make: _____ Model _____ Serial No. _____

Nitrification Field: No Fields 1 Square Feet 1200 Linear Feet 400

No Lines 5@80' Trench Width 36" Max Trench Bottom Depth 24" Gravel Depth 12"

☑ New System ☐ Repair System Type: I, II, III, IV, V, VI

System Description: gravity conventional

Repair System Description: 1 gravel pumped chambered

Maintenance Agreement Required: ☐ Yes ☑ No

☑ House/Mod. Home No. Bedrooms 3

☐ Mobile Home No. Bathrooms 2

☐ Business No. Employees ____

☐ Other _____

☑ Slab ☐ Crawl Space ☐ Basement w/plumbing ☐ Basement wo/plumbing


Water Supply:
☑ Individual
☑ Community
☐ Public

Comments:

Comments:

1"=50'

INITIAL SITE SKETCH

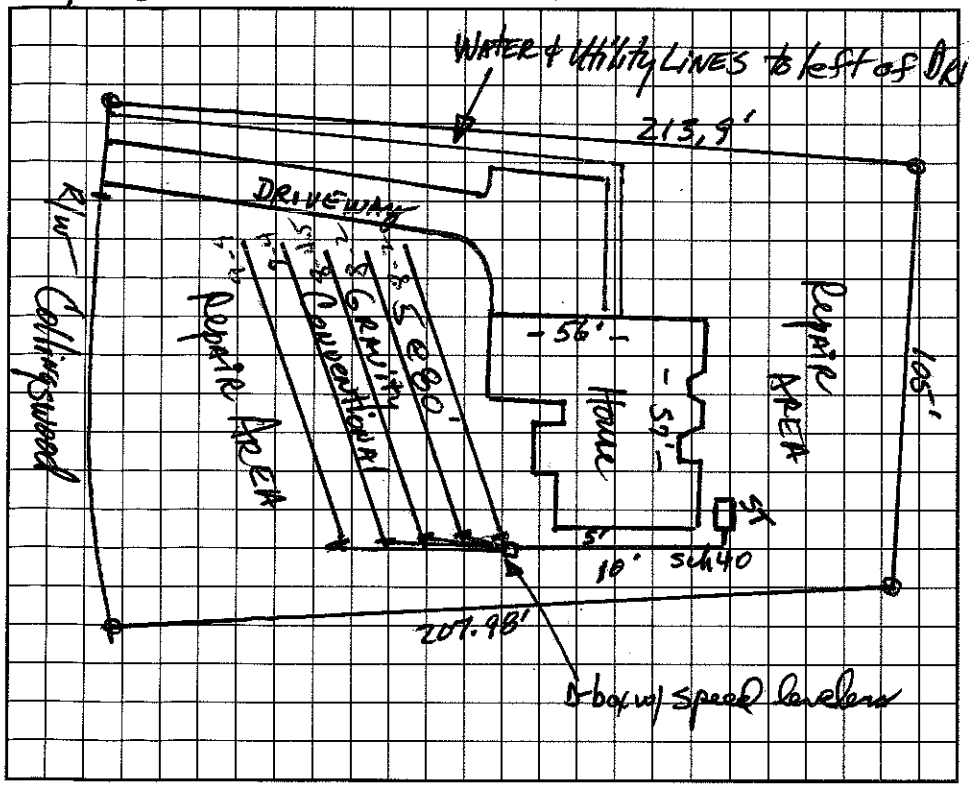

AS BUILT SKETCH

I understand that this permit can be ~~suspended~~ or revoked if any false information is supplied toward securing the permit/any unauthorized changes are made to the site/any unauthorized changes are made in the installation of the system. Improvement Permit is valid for 60 months from date of issuance.

Signed: E Krapovicky

Improvement Permit by: [signature] RS date 9-29-97

~~Existing System Inspection by~~ Construction Authorization: [signature] RS date 9-30-97

Installed by: Dellinger Septic Service

Certificate of Completion by: Wesley Sparks RSS. date 6/3/98

Operation Permit by: Wesley Sparks RS date 6/3/98

HEALTH DEPT. COPY: WHITE INSPECTION COPY (FINAL): GREEN OWNER COPY (FINAL): YELLOW INSPECTION COPY (INITIAL): PINK OWNER COPY (INITIAL): GOLD