4:00

IREDELL COUNTY HEALTH DEPARTMENT

Const Auth STATESVILLE 704-878-5305 MOORESVILLE 704-664-5281

IMPROVEMENT PERMIT / ~~CERTIFICATE OF COMPLETION~~ / OPERATION PERMIT / EXISTING SYSTEM INSPECTION

PROPERTY DESCRIPTION NO. 239787 DATE Nov. 5, '96 TAX MAP NO. Part of 25A80 Watershed: ☑ Yes ☐ No

OWNER OR CONTRACTOR ~~Stumpy Creek LLC~~ STEVE GAGEL PHONE: Business 633-6124 ~~Home~~ 4638-58-9275

ADDRESS 614 N. Main Salisbury NC 28144

LOCATION Davis Rd. W., TL Stumpy Creek Rd. TL Collingswood Rd SR 1149 left

SUBDIVISION Harborview BLOCK / SECTION III LOT 19 LOT AREA .57 SITE CLASS. PS prev. 1956 DESIGN FLOW ~~480 gpd~~ 360 gpd L.T.A.R. .3 Revised 3/14/97

Septic Tank: 1000 Gallons; STB 794 Date 8/26/97

Pump Tank: _____ Gallons; PT _____ Date _____

Pump Make: _____ Model _____ Serial No. _____

Nitrification Field: No Fields 1 Square Feet 1200 Linear Feet 400

No Lines 5 @ 80' Trench Width 36" Max Trench Bottom Depth ~24" Gravel Depth NA

☑ New System ☐ Repair System Type: I, II, III, IV, V, VI CONVENTIONAL

System Description: gravity chambered

Repair System Description: ~~gravity~~ pumped chambered

Maintenance Agreement Required: ☐ Yes ☑ No

☑ House/Mod. Home ☐ Mobile Home ☐ Business ☐ Other

No. Bedrooms ~~4~~ 3 No. Bathrooms 2½ No. Employees ____

☑ Slab ☐ Crawl Space ☐ Basement w/plumbing ☐ Basement wo/plumbing


Water Supply: ☐ Individual ☑ ~~Community~~ ☐ Public

Comments:

Comments:

1" = 50'

INITIAL SITE SKETCH

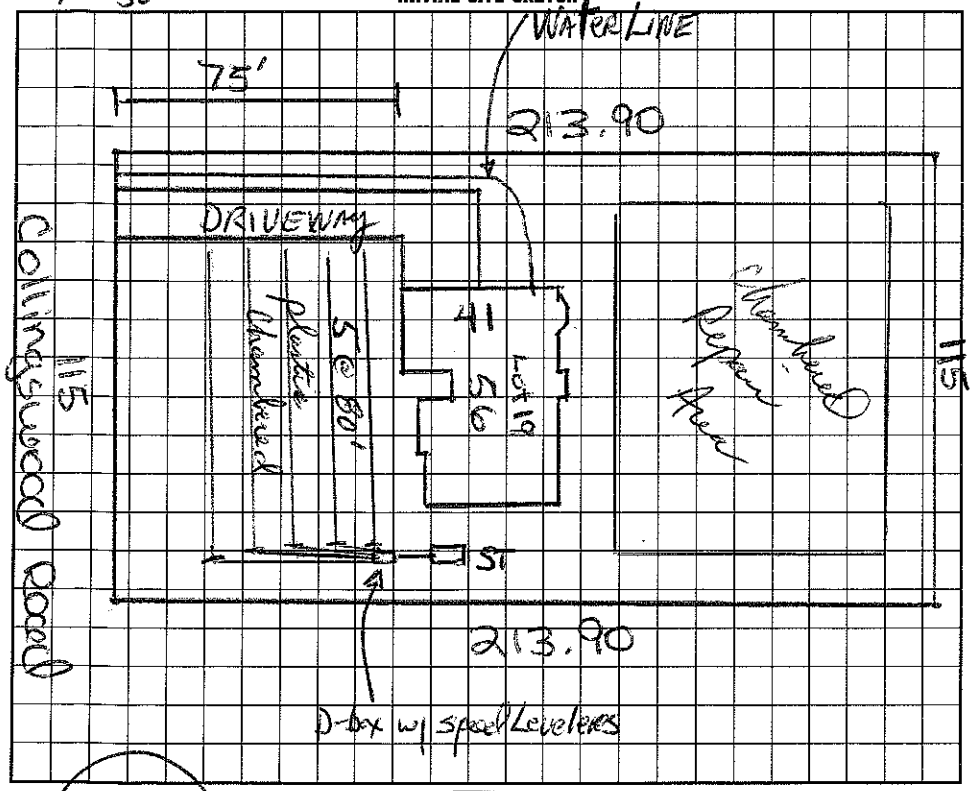

AS BUILT SKETCH

SAME AS Sketch

I understand that this permit can be suspended or revoked if any false information is supplied toward securing the permit/any unauthorized changes are made to the site/any unauthorized changes are made in the installation of the system.

Signed: _____

Improvement Permit by: Mark R. Hanson, RS date 11-5-96

~~Existing System Inspection by~~ CONSTRUCTION Authorization: Wesley Sparks RS date 2/3/97

Installed by: DC CONSTRUCTION

Certificate of Completion by: _____ date _____

Operation Permit by: _____ date 11/20/97

HEALTH DEPT. COPY: WHITE INSPECTION COPY (FINAL): GREEN OWNER COPY (FINAL): YELLOW INSPECTION COPY (INITIAL): PINK OWNER COPY (INITIAL): GOLD