IREDELL COUNTY HEALTH DEPARTMENT

STATESVILLE 704-878-5305 MOORESVILLE 704-664-5281

IMPROVEMENT PERMIT / AUTHORIZATION TO CONSTRUCT / OPERATION PERMIT / EXISTING SYSTEM INSPECTION

PERMIT# 139007 PIN# 4638590548 DATE 1-31-08

OWNER OR APPLICANT Mike McKee PHONE: Business 704-660-3008 Home 704-696-0047
202-4358 cell

ADDRESS 130 Autry Ave

LOCATION 21 N TL Cornelius cross Perth to Liva Ln TL Stumpy Creek TR Dearborn on right (115 Dearborn)

SUBDIVISION C.L.&T. BLOCK / SECTION 14 LOT 111 LOT AREA .959Ac. SITE CLASS. PS DESIGN FLOW 480gpd L.T.A.R. .39gpd/ft² .25 Repair

Septic Tank: 1000 Gallons: STB 794 Date 1-21-08
Pump Tank: 1000 Gallons: PT 283 Date 1-12-08
Pump Make: Goulds Model PES5M Serial No.
Nitrification Field: No Fields 1 Square Feet 1200 Linear Feet 400
No Lines 5@80' Trench Width 36" Max Trench Bottom Depth 36"

☒ New System ☐ Repair ☐ Expansion System Type: I II (III) IV V VI
System Description: 25% reduction pm
Repair System Description: LP PPBPS
Maintenance Agreement Required: ☐ Yes ☒ No

☒ House/Mod. Home No. Bedrooms 4
☐ Mobile Home No. Persons 8
☐ Business No. Employees
☐ Other

Water Supply: ☒ Individual ☐ Public ☐ Community


Gravel Depth N/A ☐ Gravity ☒ Pressure ☐ Slab ☐ Crawl Space ☐ Basement w/plumbing ☐ Basement wo/plumbing

1/2 HP

Comments:/Conditions: 30" compacted cover over supply line under drive required or use ductile iron. capped well has no official documentation of abandonment. Wells must be 100' + from any part of septic system or repair

1" = 60'

INITIAL SITE SKETCH

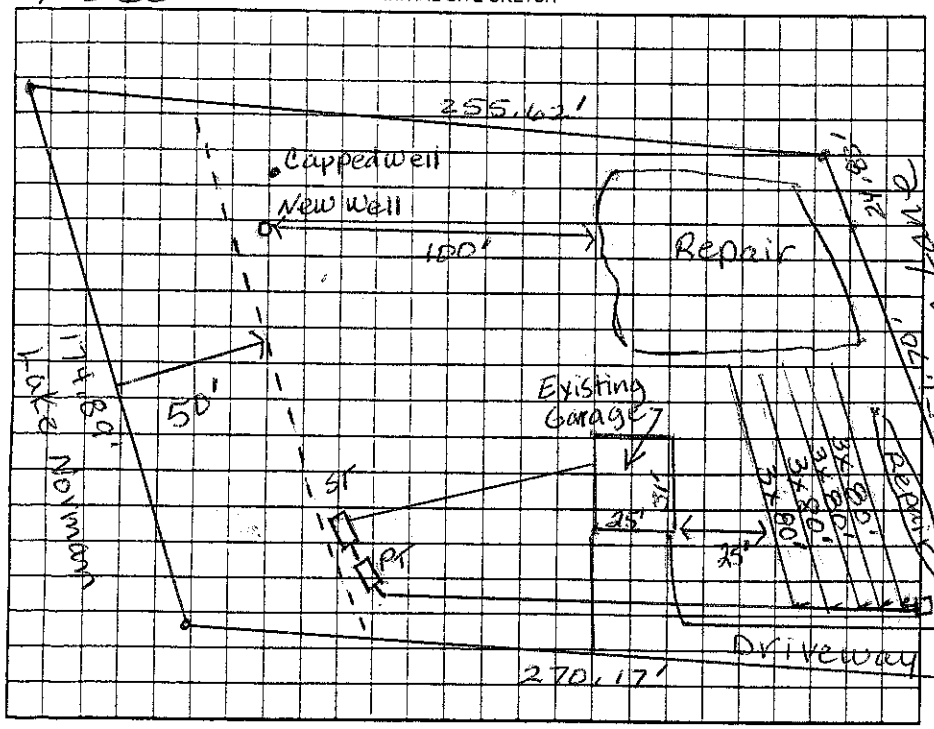

Comments:/Conditions: Remove surface fill from repair area before installing Repair Rich G Installed as Drawn

AS BUILT SKETCH

3/10/08 48" Supply line under drive
3/17/2010 Need to add another riser to have 6"

Permit can be suspended or revoked if any false information is supplied toward securing the permit/any unauthorized changes are made to the site/any unauthorized changes are made in the installation of the system. Improvement Permit with plat valid without expiration ☐ Improvement Permit with site plan valid for sixty months ☒ Authorization to Construct is valid for a period equal to that of Improvement Permit – not to exceed sixty months.

Signed: date 1-31-08

Improvement Permit by: Judy Melville date 1-31-08

Authorization to Construct by: Judy Melville date 1-31-08

Installed by: Richard Abernathy

Operation Permit by: Mark Dobson RS date 3/17/2010

Existing System Inspection by: date

HEALTH DEPT. COPY: WHITE OWNER COPY (FINAL): YELLOW OWNER COPY (INITIAL): PINK