IREDELL COUNTY HEALTH DEPARTMENT

STATESVILLE 704-878-5305 MOORESVILLE 704-664-5281

IMPROVEMENT PERMIT / AUTHORIZATION TO CONSTRUCT / OPERATION PERMIT / EXISTING SYSTEM INSPECTION

PERMIT# 132953 PIN# 4638 59 1807 DATE 2/2/06

OWNER OR CONTRACTOR Edward M. Wallace PHONE: Business 704-363-1490 Home

ADDRESS 554 Oak Tree Rd Mooresville NC 28115

LOCATION Perth, TL Stumpy Crk, TL Dearborn, Near End on Rt

SUBDIVISION CL&T BLOCK / SECTION 14 LOT 115 LOT AREA 0.93 ac SITE CLASS. RS DESIGN FLOW 480 L.T.A.R. 0.85

Septic Tank: 1000 Gallons; STB Ex-3 Date

Pump Tank: 1000 Gallons; PT Ex-3 Date

Pump Make: Model Serial No.

Nitrification Field: No Fields Square Feet Linear Feet 343

No Lines 4 Trench Width Max Trench Bottom Depth Gravel Depth

☐ New System ☐ Repair System Type: I, II, (III), IV, V, VI

System Description: Ex. 25% Reduction

Repair System Description: Limited - Deed Prior

Maintenance Agreement Required: ☐ Yes ☒ No to 1983

☒ House/Mod. Home No. Bedrooms 4

☐ Mobile Home No. Bathrooms

☐ Business No. Employees

☐ Other


☐ Slab ☐ Crawl Space ☒ Basement w/plumbing ☐ Basement wo/plumbing

Water Supply: ☒ Individual ☐ Public ☐ Community


Comments:/Conditions:

Comments:/Conditions: Note: Drive ~ 20ft off Rd

INITIAL SITE SKETCH

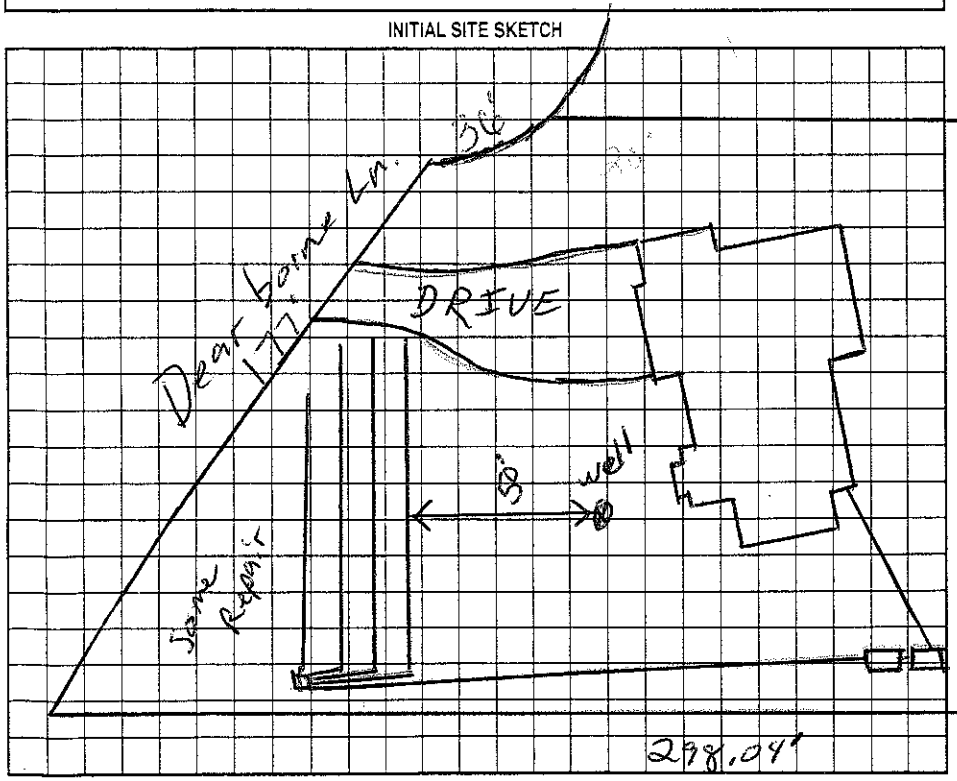

AS BUILT SKETCH

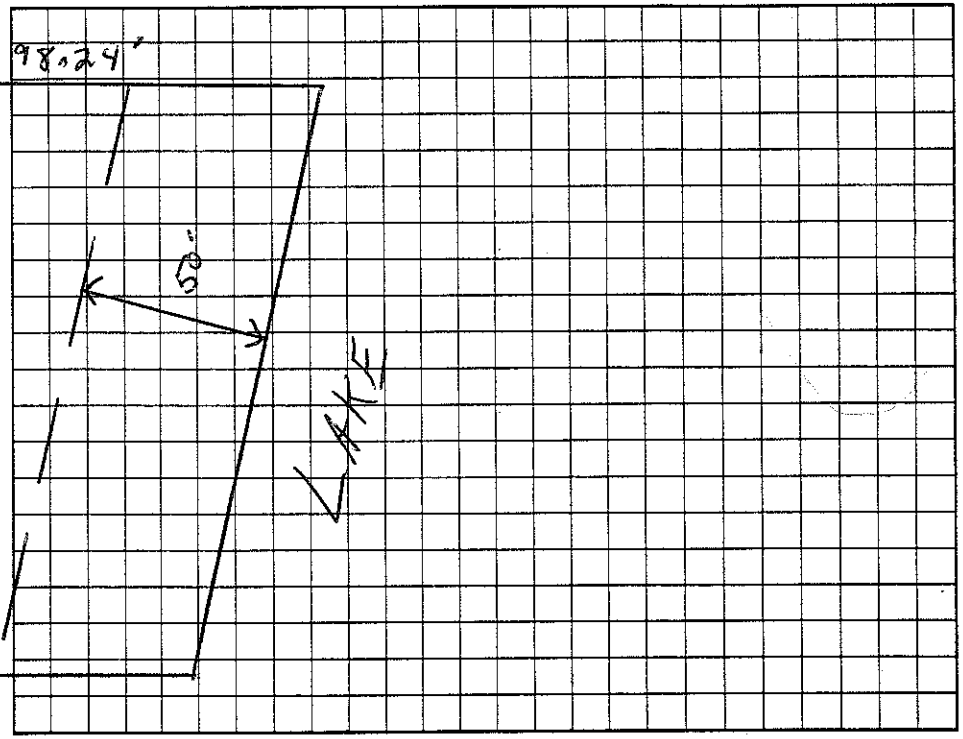

Permit can be suspended or revoked if any false information is supplied toward securing the permit/any unauthorized changes are made to the site/any unauthorized changes are made in the installation of the system. Improvement Permit with plat valid without expiration. Improvement Permit with site plan valid for sixty months. Authorization to Construct is valid for a period equal to that of Improvement Permit – not to exceed sixty months.

Signed: Janak Wallace date 2-3-06 Installed by:

Improvement Permit by: date Operation Permit by: date

Authorization to Construct by: date Existing System Inspection by RS date 2/2/06

HEALTH DEPT. COPY: WHITE OWNER COPY (FINAL): YELLOW OWNER COPY (INITIAL): PINK

IREDELL COUNTY HEALTH DEPARTMENT

STATESVILLE 704-878-5305 MOORESVILLE 704-6 1

IMPROVEMENT PERMIT / AUTHORIZATION TO CONSTRUCT / OPERATION PERMIT / EXISTING SYSTEM INSPECTION

PERMIT# 108985 PIN# 4638-59-1807 DATE 10/01/02

OWNER OR CONTRACTOR Bobbie Kumon PHONE: Business Home 704-528-2359

ADDRESS 114 Dearborn Ln Mooresville NC 28117

LOCATION North TL Stumpy Creek, TL Dearborn, Near Endor Rd.

SUBDIVISION Clift BLOCK / SECTION 14 LOT 115 LOT AREA 0.93 Ac. SITE CLASS. PS DESIGN FLOW 480 L.T.A.R. 0.35

Septic Tank: 1000 Gallons; STB 1012 Date 10/13/02

Pump Tank: 1000 Gallons; PT 17 Date 9/11/02

Pump Make: Goulds Model WE0511H Serial No.

Nitrification Field: No Fields 1 Square Feet 1032 Linear Feet 344

No Lines 5 Trench Width 36" Max Trench Bottom Depth 36" Gravel Depth —

☒ New System ☐ Repair System Type: I, II, III, IV, V, VI

System Description: Press. Man. 25% Reduction

Repair System Description: Limited - Needed Prior to

Maintenance Agreement Required: ☐ Yes ☒ No 1983

☒ House/Mod. Home ☐ Mobile Home ☐ Business ☐ Other

No. Bedrooms 4 No. Bathrooms 3 No. Employees


☐ Slab ☒ Crawl Space ☐ Basement w/plumbing ☐ Basement wo/plumbing

Water Supply: ☒ Individual ☐ Public ☐ Community


Comments:/Conditions:

Comments:/Conditions:

INITIAL SITE SKETCH

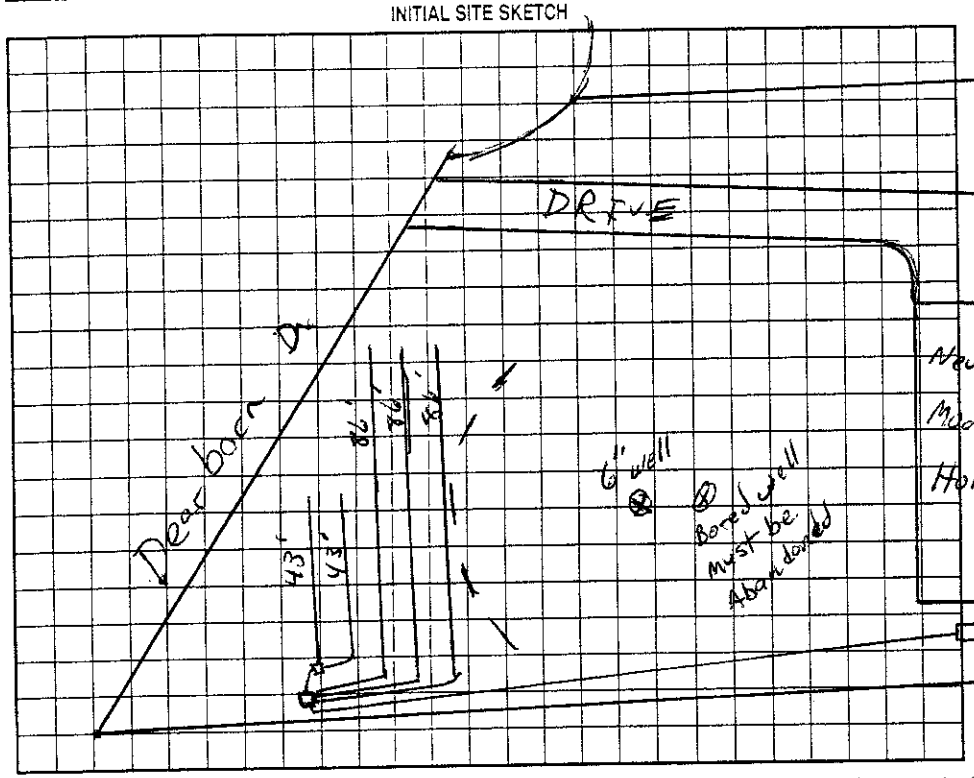

AS BUILT SKETCH

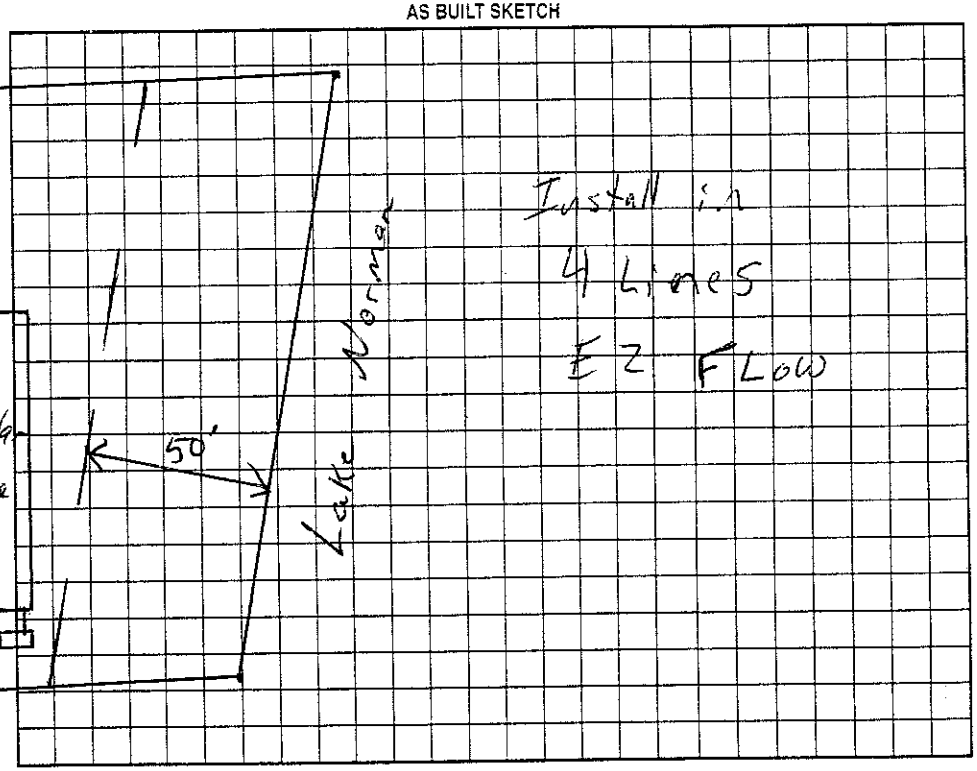

Permit can be suspended or revoked if any false information is supplied toward securing the permit/any unauthorized changes are made to the site/any unauthorized changes are made in the installation of the system. Improvement Permit with plat valid without expiration. Improvement Permit with site plan valid for sixty months. Authorization to Construct is valid for a period equal to that of Improvement Permit – not to exceed sixty months.

Signed: date 10/1/02 Installed by: A-1 Backhoe

Improvement Permit by: RS date 10/01/02 Operation Permit by: RS date 1/15/03

Authorization to Construct by: RS date 10/01/02 Existing System Inspection by: date

HEALTH DEPT. COPY: WHITE OWNER COPY (FINAL): YELLOW OWNER COPY (INITIAL): PINK