$280

IREDELL COUNTY HEALTH DEPARTMENT

STATESVILLE 704-878-5305 MOORESVILLE 704-6 1

IMPROVEMENT PERMIT / AUTHORIZATION TO CONSTRUCT / OPERATION PERMIT / EXISTING SYSTEM INSPECTION

PERMIT# 108 985 PIN# 4638-59-1807 DATE 10/01/02

OWNER OR CONTRACTOR Bobbie Kumon PHONE: Business _____ Home 704-528-2359

ADDRESS 114 Dearborn Ln Mooresville NC 28117

LOCATION Perth TL Stumpy Creek, TL Dearborn, Near End on RT.

SUBDIVISION CL+T BLOCK / SECTION 14 LOT 115 LOT AREA 0.93 Ac. SITE CLASS. PS DESIGN FLOW 480 L.T.A.R. 0.35

Septic Tank: 1000 Gallons; STB 1012 Date 10/13/02
Pump Tank: 1000 Gallons; PT 17 Date 9/16/02
Pump Make: Goulds Model WE0511H Serial No. _____
Nitrification Field: No Fields 1 Square Feet 1032 Linear Feet 344
No Lines 5 Trench Width 36" Max Trench Bottom Depth 36" Gravel Depth —

☒ New System ☐ Repair System Type: I, II, III, IV, V, VI
System Description: Press. Man. 25% Reduction
Repair System Description: Limited - Needed Prior to
Maintenance Agreement Required: ☐ Yes ☒ No 1983

☒ House/Mod. Home No. Bedrooms 4
☐ Mobile Home No. Bathrooms 3
☐ Business No. Employees _____
☐ Other _____


☐ Slab ☒ Crawl Space ☐ Basement w/plumbing ☐ Basement wo/plumbing

Water Supply: ☒ Individual ☐ Public ☐ Community


Comments:/Conditions:

Comments:/Conditions:

INITIAL SITE SKETCH

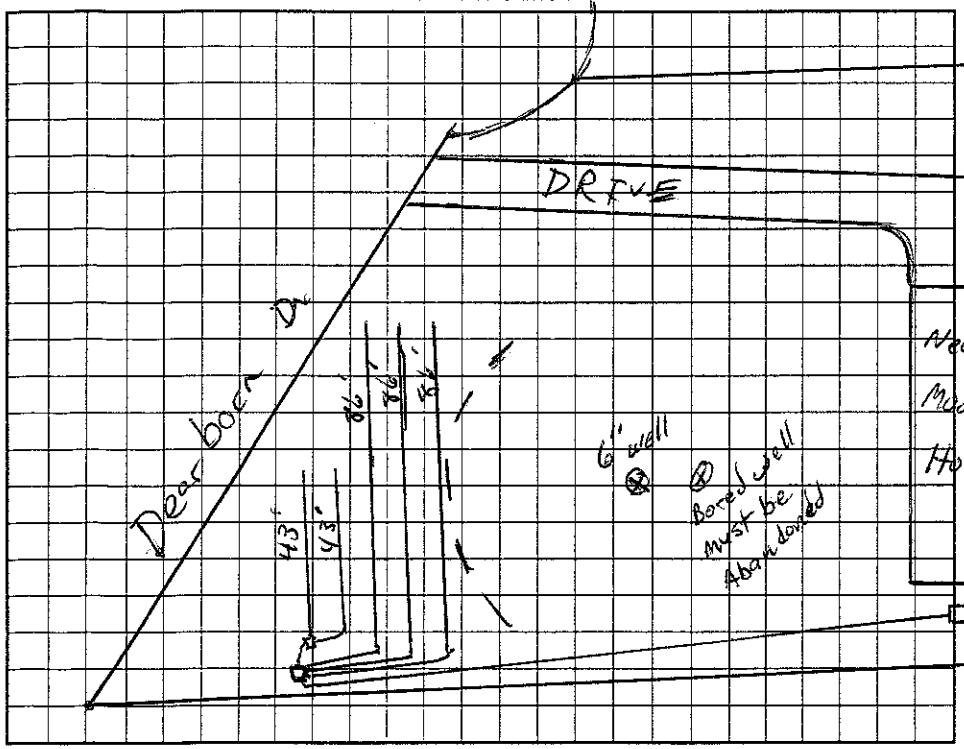

AS BUILT SKETCH

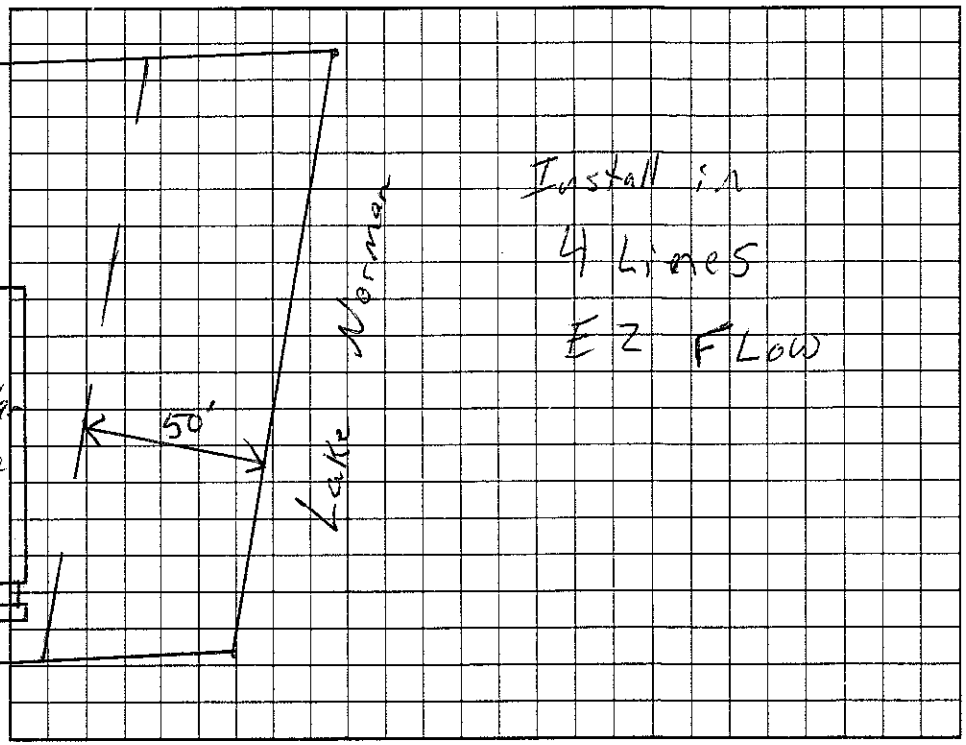

Permit can be suspended or revoked if any false information is supplied toward securing the permit/any unauthorized changes are made to the site/any unauthorized changes are made in the installation of the system. Improvement Permit with plat valid without expiration. Improvement Permit with site plan valid for sixty months. Authorization to Construct is valid for a period equal to that of Improvement Permit – not to exceed sixty months.

Signed: _____ date 10/1/02 Installed by: A-1 Backhoe

Improvement Permit by: RS date 10/01/02 Operation Permit by: RS date 1/15/03

Authorization to Construct by: RS date 10/01/02 Existing System Inspection by: _____ date _____

HEALTH DEPT. COPY: WHITE OWNER COPY (FINAL): YELLOW OWNER COPY (INITIAL): PINK