4638592873

IREDELL COUNTY HEALTH DEPARTMENT

STATESVILLE 704-878-5305 MOORESVILLE 704-664-5281

IMPROVEMENT PERMIT / CERTIFICATE OF COMPLETION / OPERATION PERMIT / EXISTING SYSTEM INSPECTION

PROPERTY DESCRIPTION NO. 19571 DATE 10/14/94 TAX MAP NO. 2S - 4A - 116 Watershed: ☐ Yes ☒ No

OWNER OR CONTRACTOR James A Kinder PHONE: Business _____ Home 528-4994

ADDRESS 106 Dearborn Way Mooresville, NC. 28115

LOCATION Stumpy Creek to access TR on Loop; about .4 mile (L) to first drive on (R), to bottom of hill on (R)

SUBDIVISION CLIFF BLOCK / SECTION 14 LOT 116 LOT AREA ~ 1 acre SITE CLASS. P DESIGN FLOW 360 L.T.A.R. _____

Septic Tank: 1000 Gallons; STB _____ Date _____

Pump Tank: _____ Gallons; PT _____ Date _____

Pump Make: _____ Model _____ Serial No. _____

Nitrification Field: No Fields Existing Square Feet _____ Linear Feet _____

No Lines _____ Trench Width 0 Max Trench Bottom Depth _____ Gravel Depth _____

☐ New System ☐ Repair System Type: I, II, III, IV, V, VI

System Description: Existing System

Repair System Description: _____

Maintenance Agreement Required: ☐ Yes ☒ No

☒ House/Mod. Home No. Bedrooms _____

☐ Mobile Home No. Bathrooms _____

☐ Business No. Employees _____

☐ Other _____

☐ Slab ☐ Crawl Space ☒ Basement w/plumbing ☐ Basement wo/plumbing

Water Supply:
☐ Individual
☐ Community
☐ Public


Comments:

Comments: Addition to go on top of the existing basement

LAKE

INITIAL SITE SKETCH

AS BUILT SKETCH

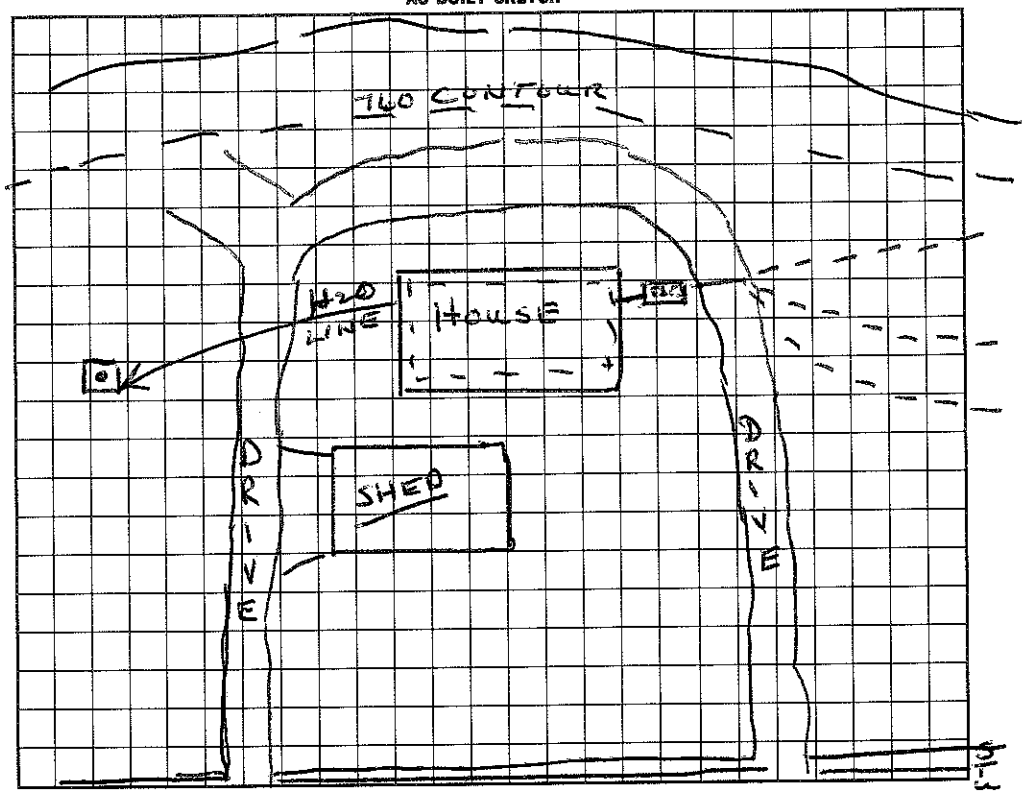

I understand that this permit can be suspended or revoked if any false information is supplied toward securing the permit/any unauthorized changes are made to the site/any unauthorized changes are made in the installation of the system. Improvement Permit is valid for 60 months from date of issuance.

Signed: _____

Improvement Permit by: _____ date _____

Existing System Inspection by: Wesley Sparks RS. date 10/14/94

Installed by: _____

Certificate of Completion by: _____ date _____

Operation Permit by: _____ date _____

HEALTH DEPT. COPY: WHITE INSPECTION COPY (FINAL): GREEN OWNER COPY (FINAL): YELLOW INSPECTION COPY (INITIAL): PINK OWNER COPY (INITIAL): GOLD